

UNITED STATES PUBLIC LAND SURVEY CORNER CERTIFICATE

OF

Land Survey Monuments situated in Section 11, Township 76N, Range 27W, of the Fifth Principal Meridian, MADISON County, Iowa. Previously recorded in DOES NOT APPLY in County Recorder's Office.



(book, page, document number, etc.)

(Show reason for preparing this certificate, the evidence and detailed procedures used in establishing the corner positions and monumentation found or placed.)

Monument Description and Remarks: FOUND 1/2" CAPPED REBAR IN NORTH ROAD DITCH, SET BY RLS #7814.

PLAN - VIEW

(Show a minimum of three reference ties to durable physical objects, relevant monuments and physical conditions that will enable recovery of the corner.)

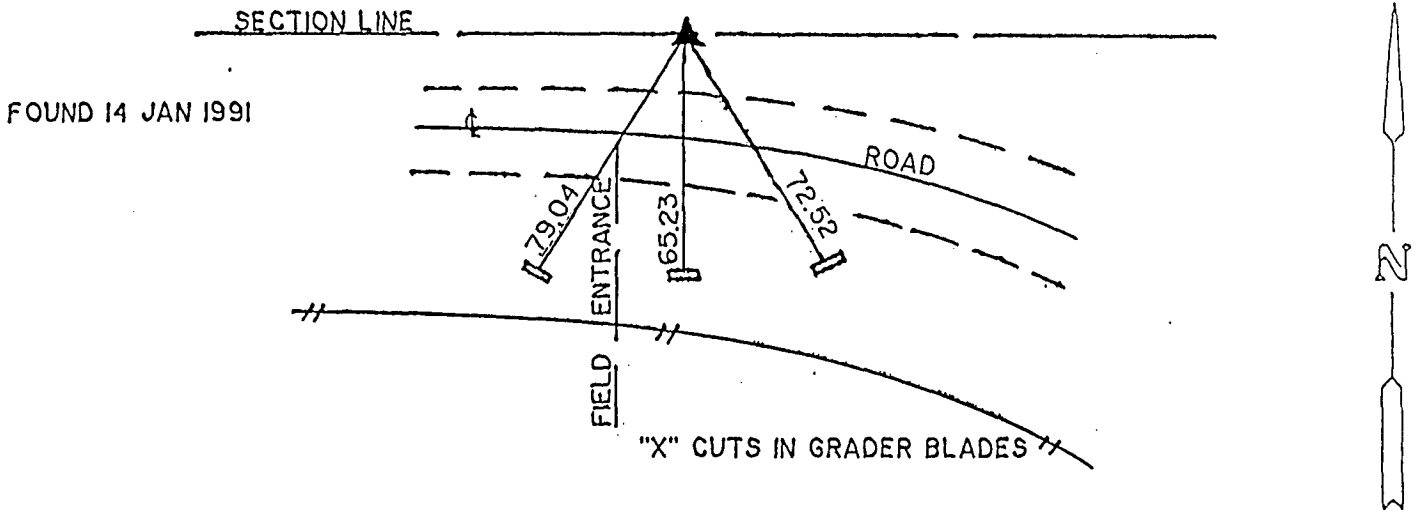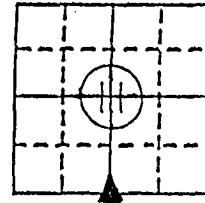

REFERENCE TO SW CORNER SE 1/4 SECTION 11, T-76N, R-27W

I hereby certify that the survey work was completed and this certificate was prepared by me or under my direct personal supervision and that I am a duly registered land surveyor under the laws of the state of Iowa.

Signature: J. Brian Morrissey
Name typed or printed: J. Brian Morrissey, P.E. & L.S.
Date: June 4, 1991 Reg. No. 7995



SEAL

Corners	List Corners to be Indexed Section	Twp	Range
SW COR SE 1/4	11	76N	27W

COMPARED

IND.
REC.
PAGE

FILED NO. **2505**

BOOK 1 PAGE 24

91 JUN -5 AM 8:12

MICHELLE UTSLER
RECORDER
MADISON COUNTY, IOWA

No Fee