
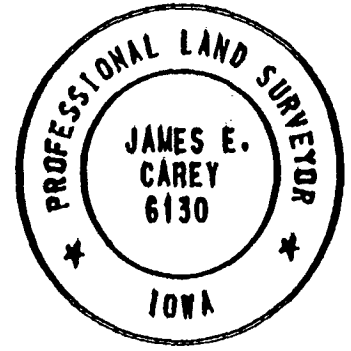


UNITED STATES PUBLIC LAND SURVEY CORNER CERTIFICATE

Section 13 Township 76 Range 28W County Madison





Certificate Prepared For: Grading and Resurfacing Project

F-169-3(30)--20-61

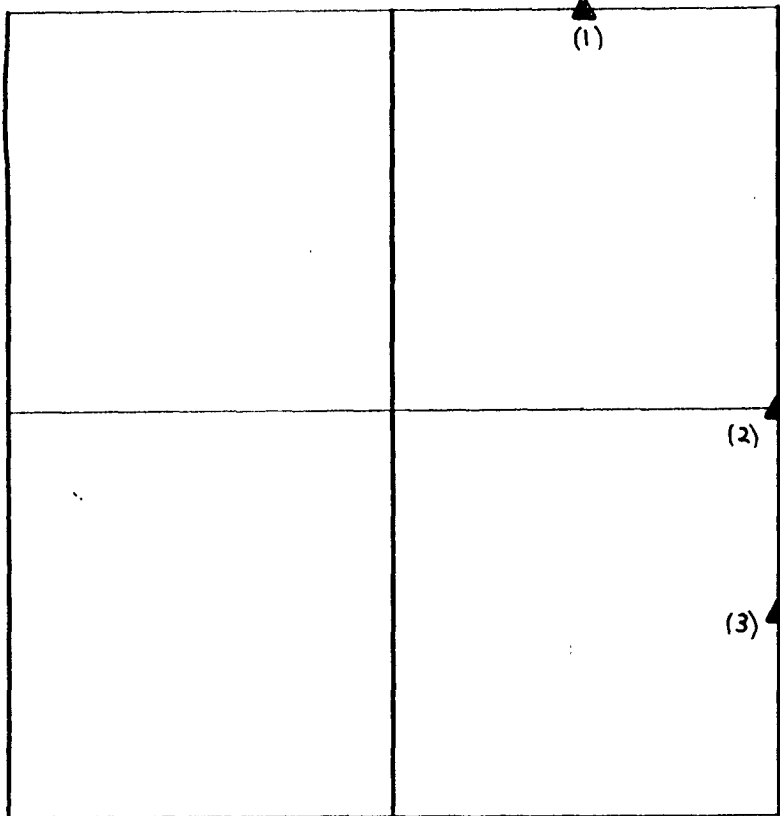

I hereby certify that this plot is a true and accurate representation of the land herein described, made by me or under my direct supervision, and that I am a duly registered Land Surveyor under the laws of the State of Iowa.

James E. Carey 7-9-92
James E. Carey Reg. No. 6130 Date

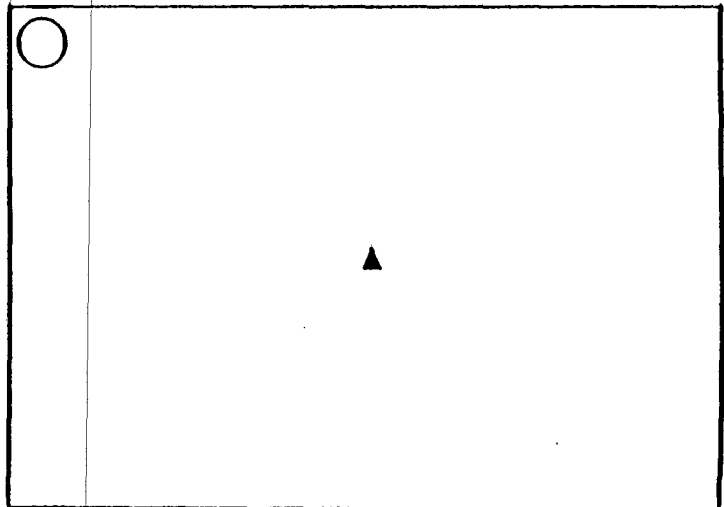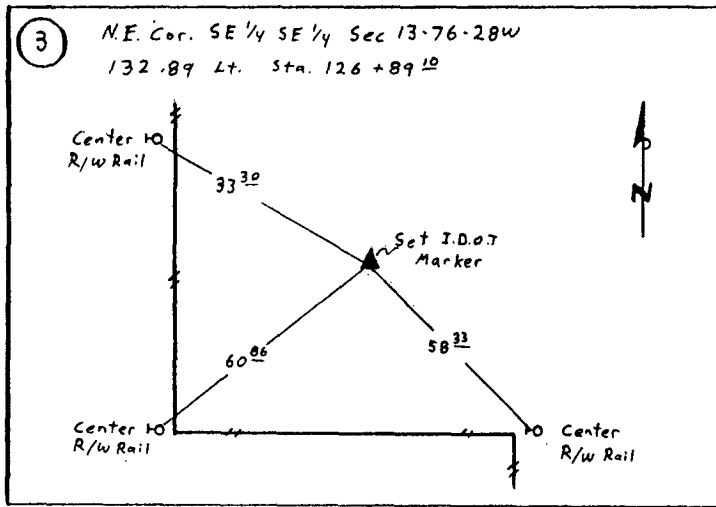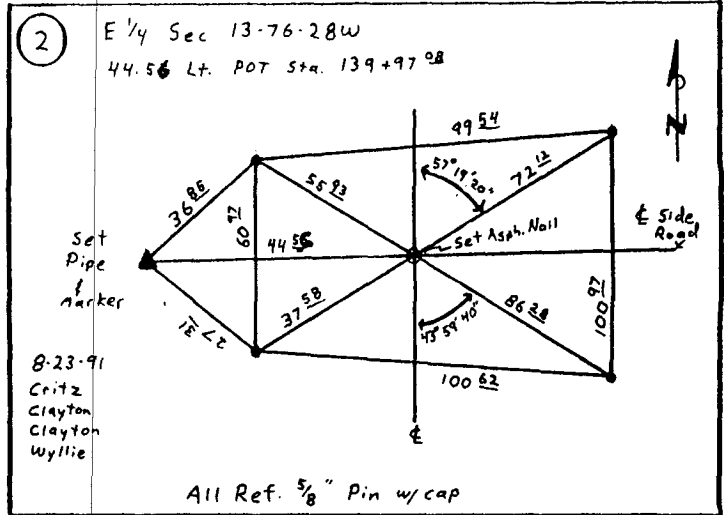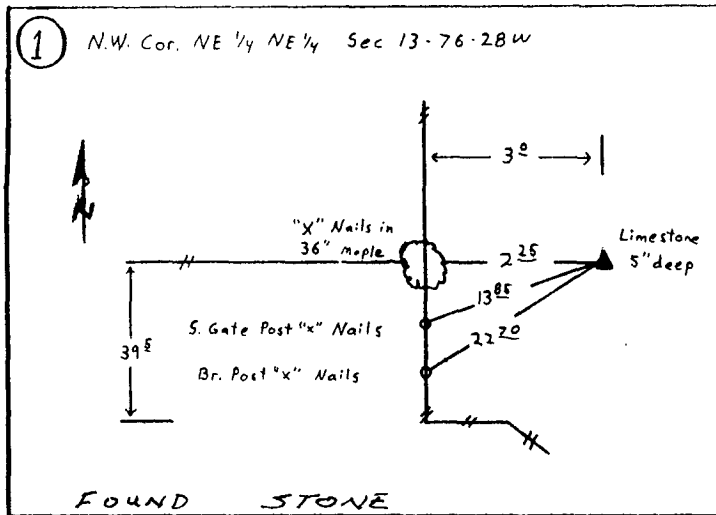

Recording Data: **92**
FILED NO.
 BOOK 1 PAGE 100
92 JUL 13 AM 11:17
 MICHELLE UTSLER
 RECORDER
 MADISON COUNTY, IOWA
 Fee \$5.00

Corner	Section	Twp	Range
NW Cor NE 1/4 NE 1/4	13	76	28W
E 1/4	13	76	28W
NE Cor SE 1/4 SE 1/4	13	76	28W