



# UNITED STATES PUBLIC LAND SURVEY CORNER CERTIFICATE



Section 24 Township 76 Range 28W County Madison





Certificate Prepared For: Grading and Resurfacing Project

F-169-3(30)--20-61

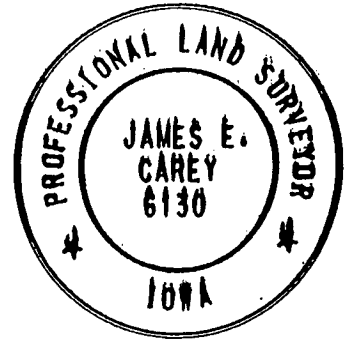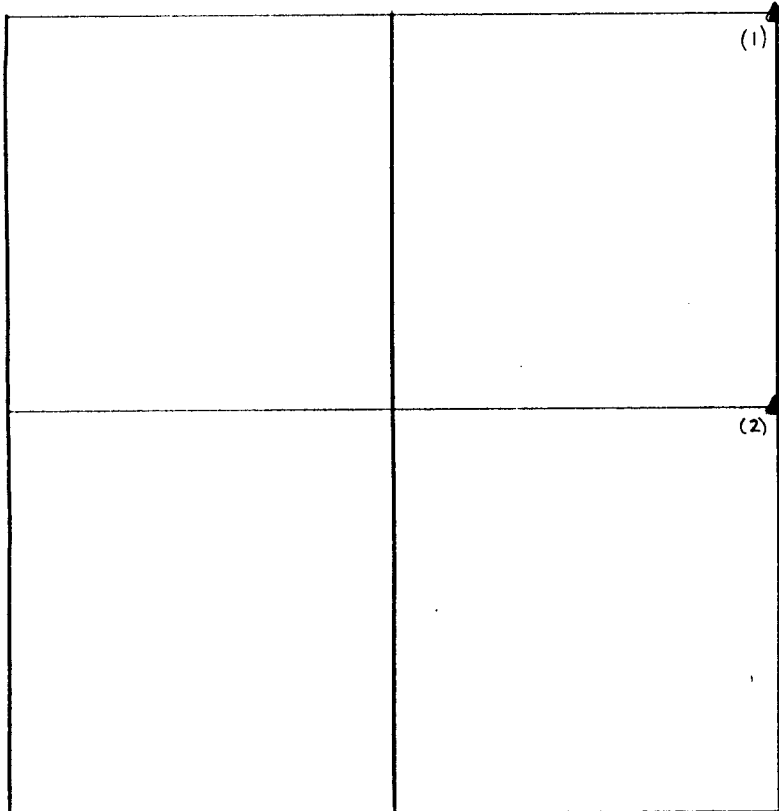

I hereby certify that this plot is a true and accurate representation of the land herein described, made by me or under my direct supervision, and that I am a duly registered Land Surveyor under the laws of the State of Iowa.

*James E. Carey* 7-9-92  
 James E. Carey Reg. No. 6130 Date

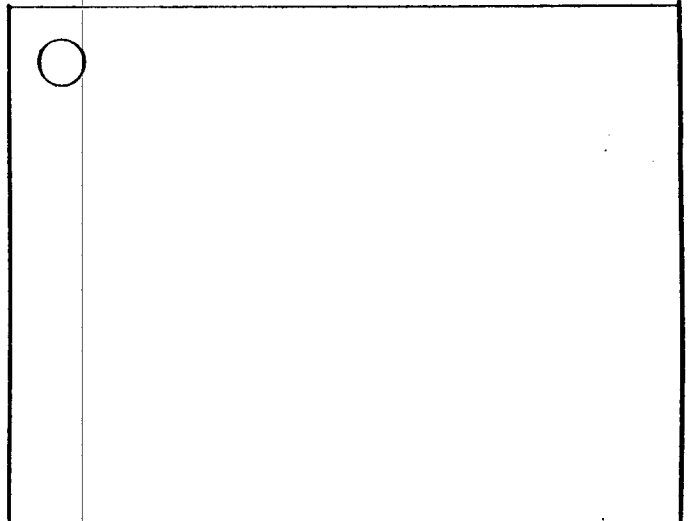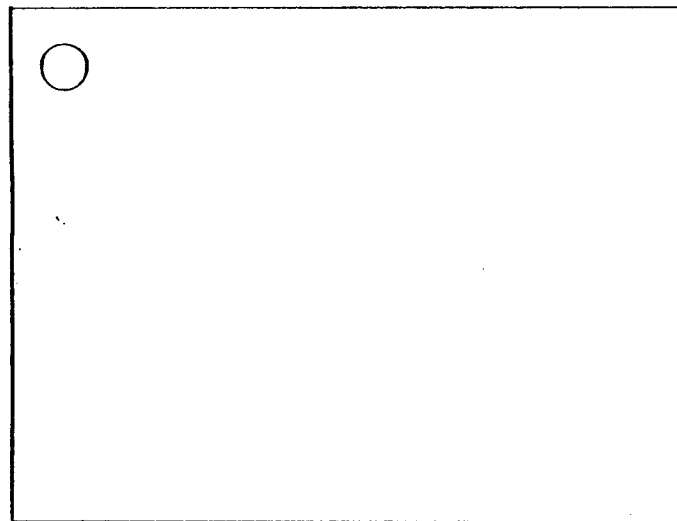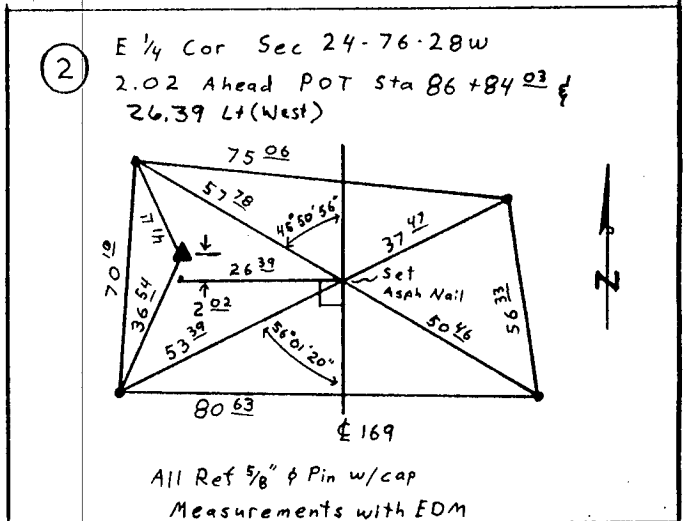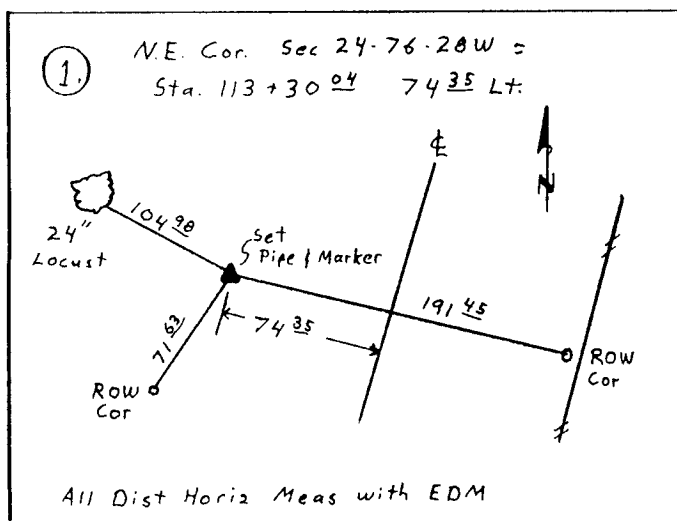

Recording Data:

FILED NO. **93**

BOOK 1 PAGE 101

92 JUL 13 AM 11:18

MICHELLE UTSLER  
 RECORDER  
 MADISON COUNTY, IOWA

Fee \$5.00

List Corner to be Indexed

Corners	Section	Twp	Range
NE	24	76	28W
E 1/4	24	76	28W

**COMPARED**

✓  
 ✓  
 ✓