



UNITED STATES PUBLIC LAND SURVEY CORNER CERTIFICATE

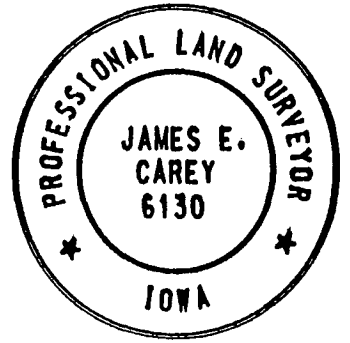





Section 25 Township 76 Range 28W County Madison

Certificate Prepared For: Grading and Resurfacing Project
F-169-3(30)--20-61

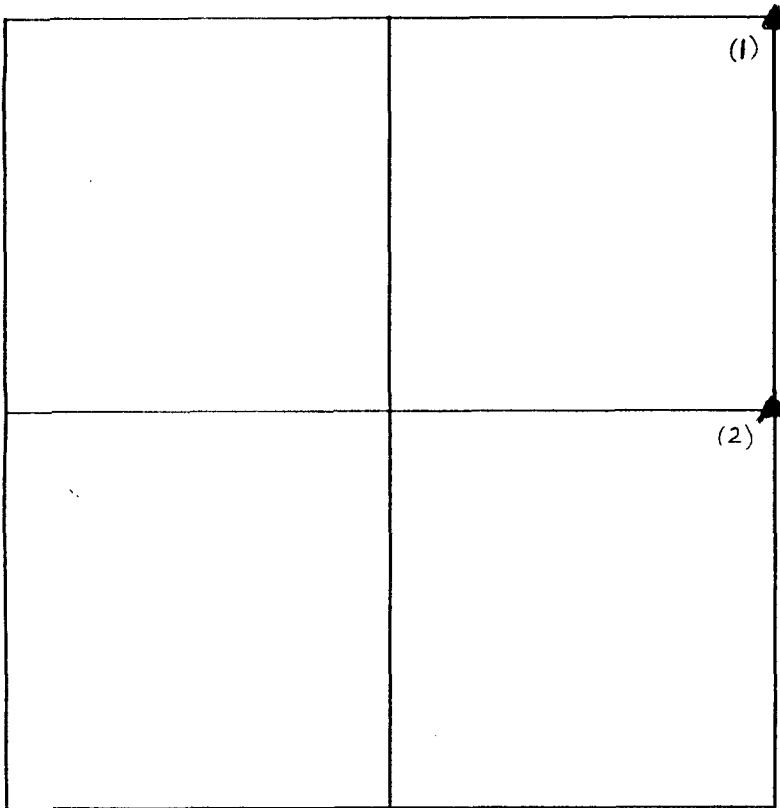

I hereby certify that this plot is a true and accurate representation of the land herein described, made by me or under my direct supervision, and that I am a duly registered Land Surveyor under the laws of the State of Iowa.

James E. Carey 7-9-92
 James E. Carey Reg. No. 6130 Date

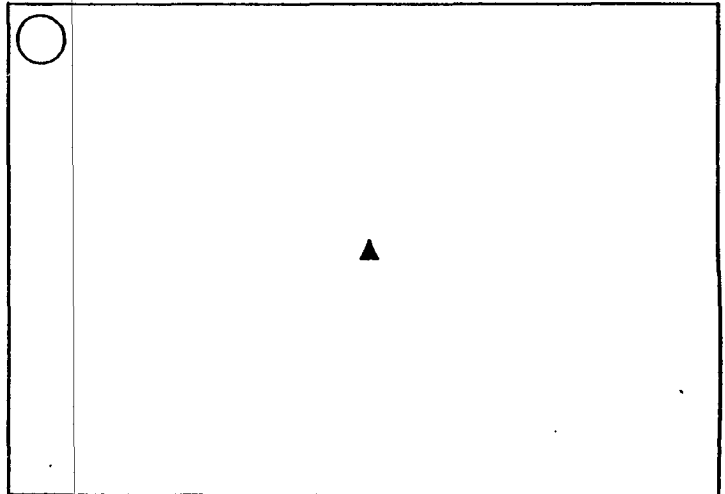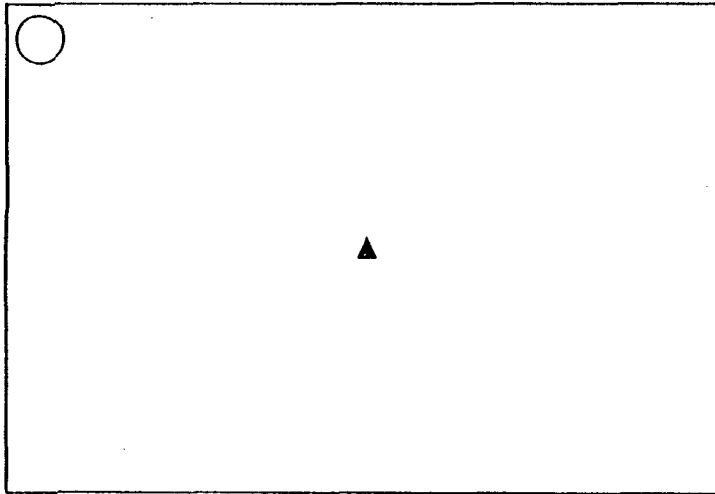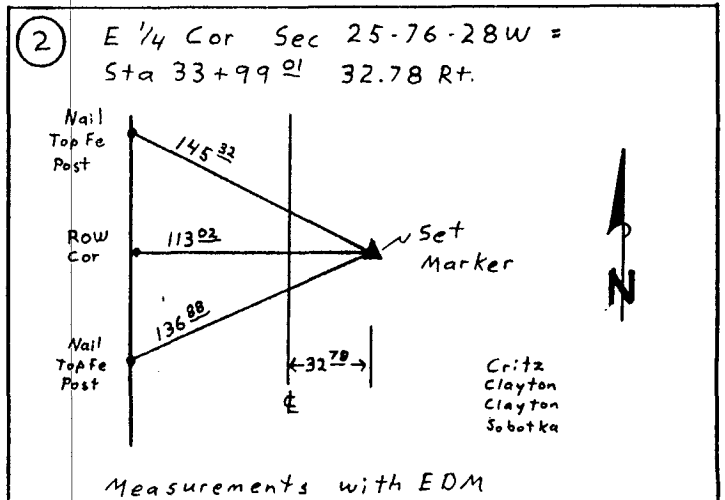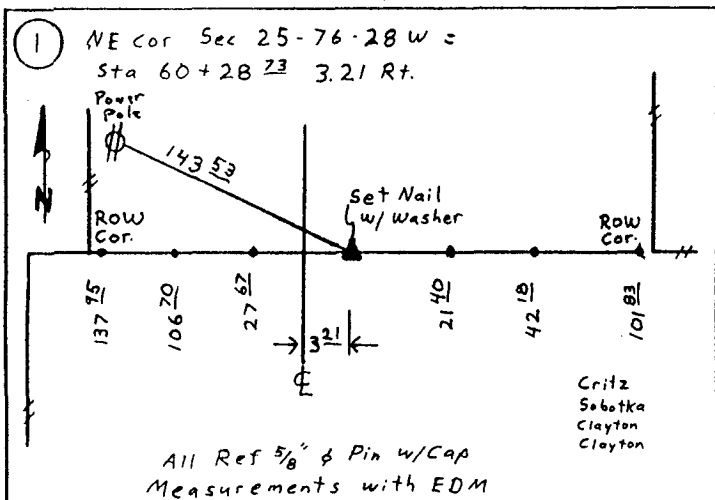

Recording Data:

COMPARED

FILED NO. 94

BOOK 1 PAGE 102

92 JUL 13 AM 11:19

MICHELLE UTSLER
 RECORDER
 MADISON COUNTY, IOWA

Fee \$5.00

List Corner to be Indexed

Corners	Section	Twp	Range
NE	25	76	28W
E 1/4	25	76	28W