
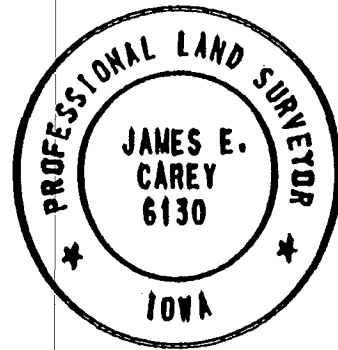


# UNITED STATES PUBLIC LAND SURVEY CORNER CERTIFICATE

Section 3 Township 75 Range 29W County Madison





Certificate Prepared For: CULVERT PROJECT

F-92-4(1)-20-61

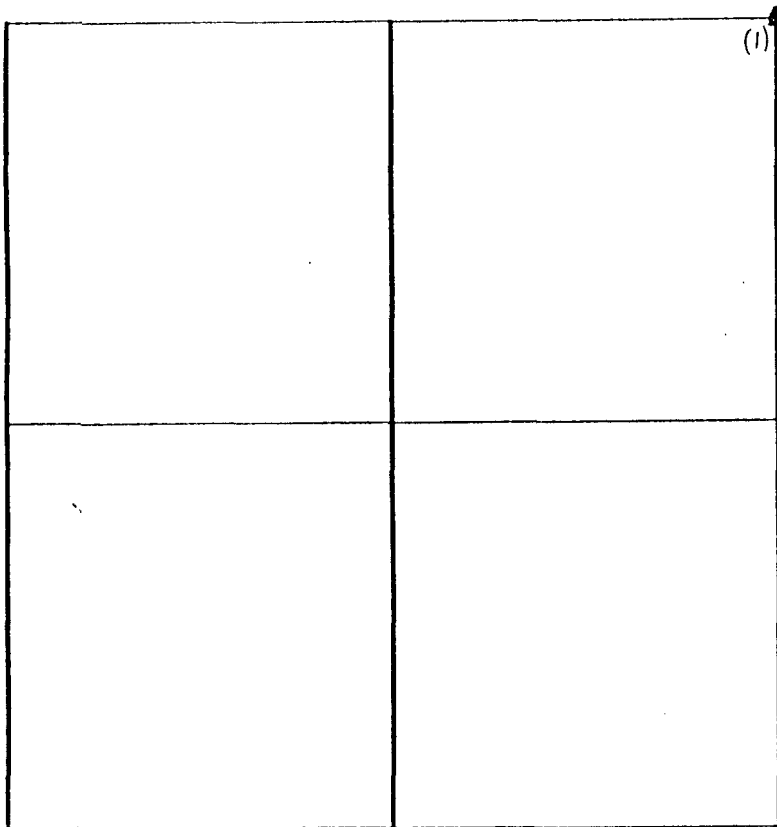

I hereby certify that this plot is a true and accurate representation of the land herein described, made by me or under my direct supervision, and that I am a duly registered Land Surveyor under the laws of the State of Iowa.

*James E. Carey* 7-9-92  
 James E. Carey Reg. No. 6130 Date

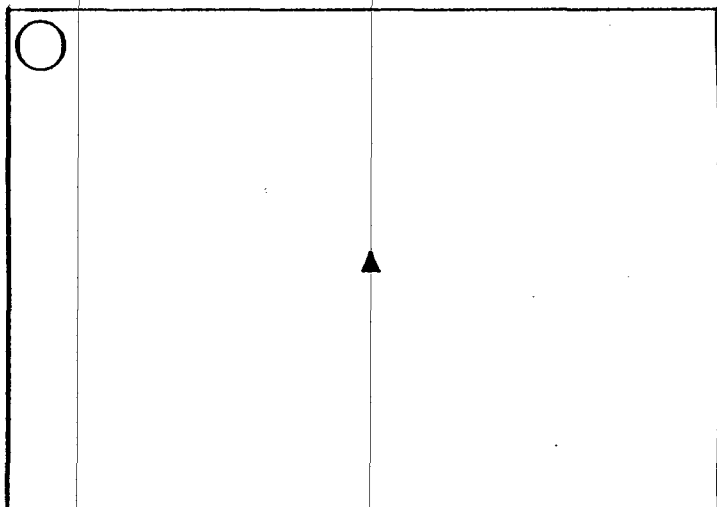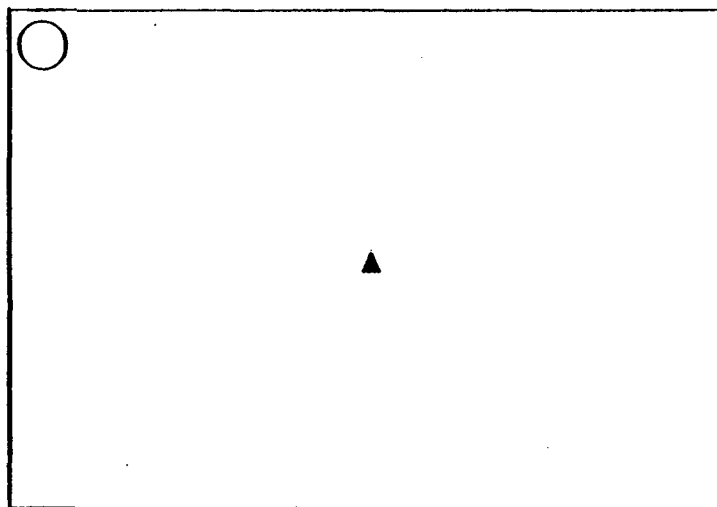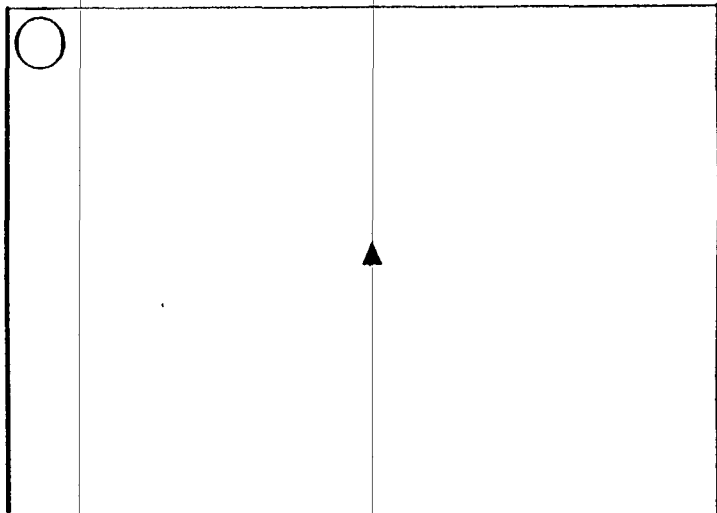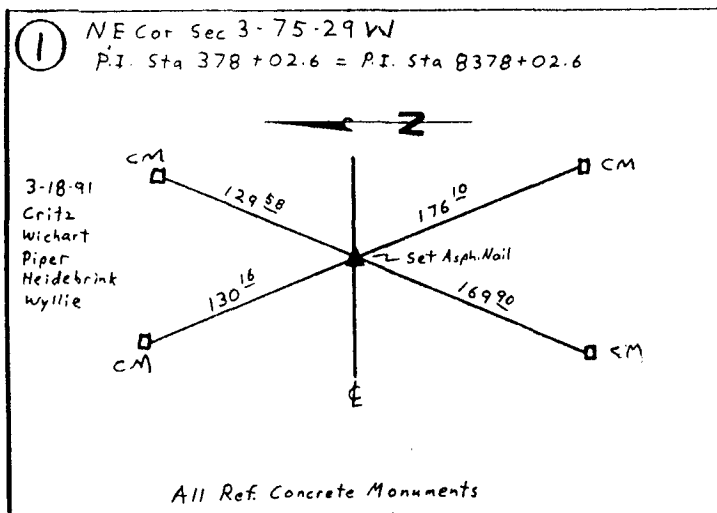

Recording Data:

COMPARED

FILED NO. 88

BOOK 1 PAGE 96

92 JUL 13 AM 11:13

MICHELLE UTSLER  
 RECORDER  
 MADISON COUNTY, IOWA

Fee \$5.00

List Corner to be Indexed

Corner

Section

Top

Range

NE Cor

3

75

29W

IND.   
 REG.   
 PAGE