



# UNITED STATES PUBLIC LAND SURVEY CORNER CERTIFICATE

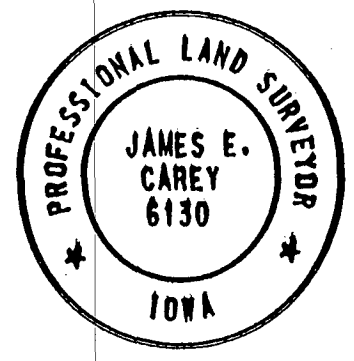





Section 1 Township 16 Range 28W County Madison

Certificate Prepared For: Grading and Resurficing Project  
F-169-3(30) -- 20-61

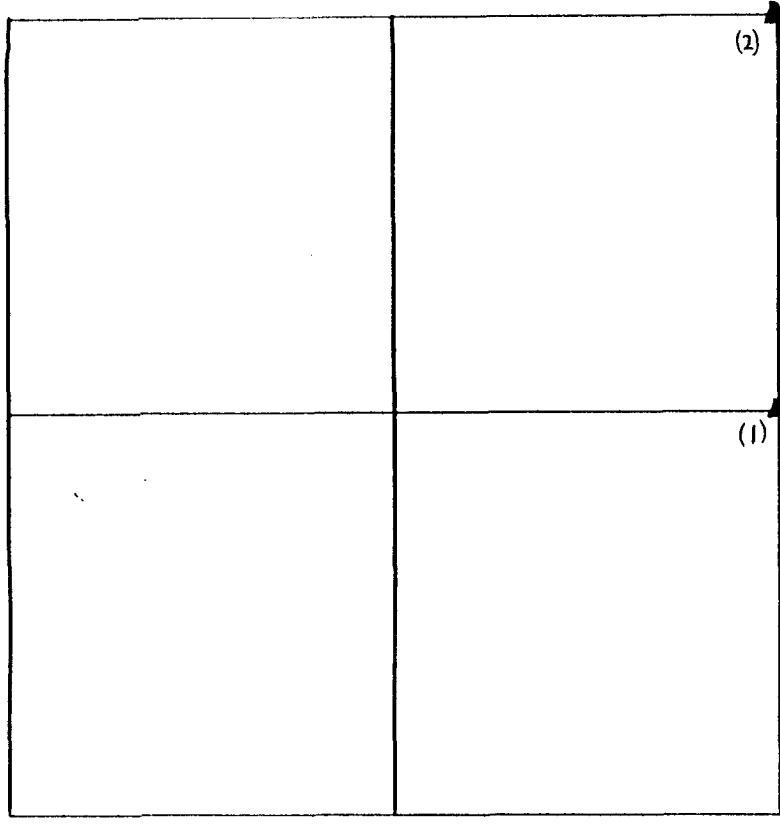

I hereby certify that this plot is a true and accurate representation of the land herein described, made by me or under my direct supervision, and that I am a duly registered Land Surveyor under the laws of the State of Iowa.

*James E. Carey* 7-9-92  
 James E. Carey Reg. No. 6130 Date

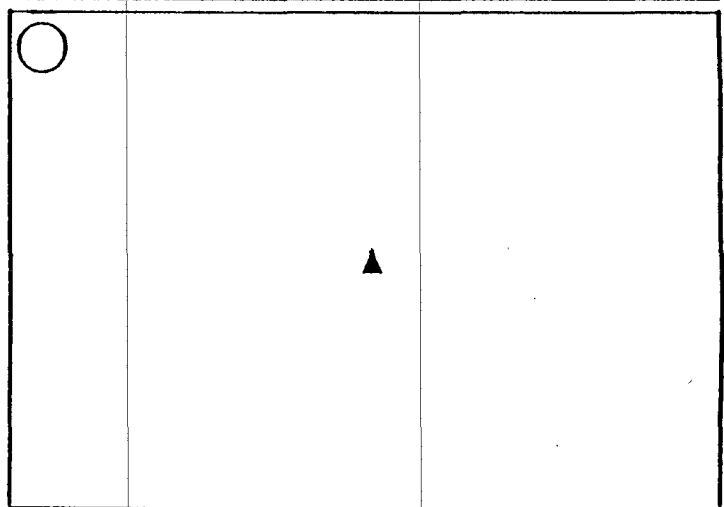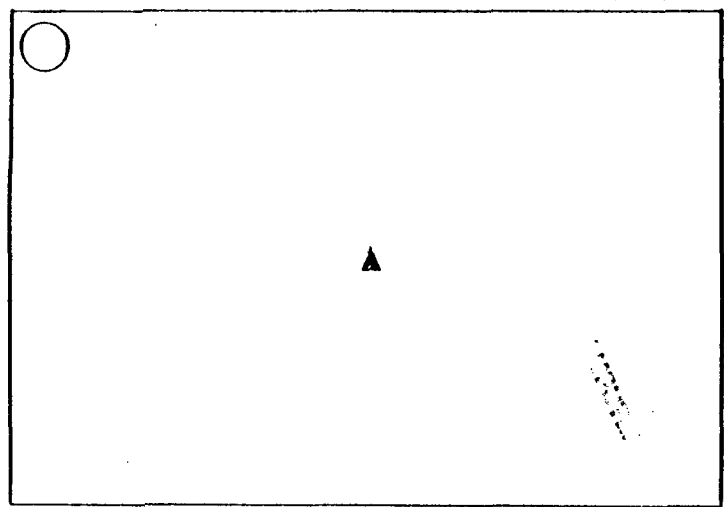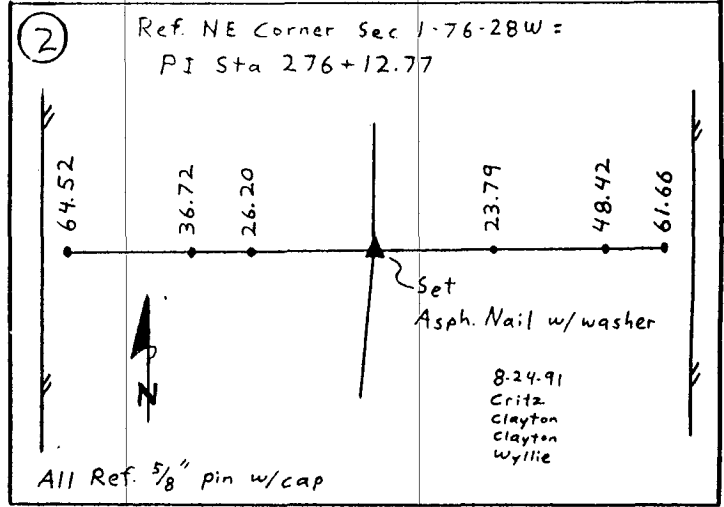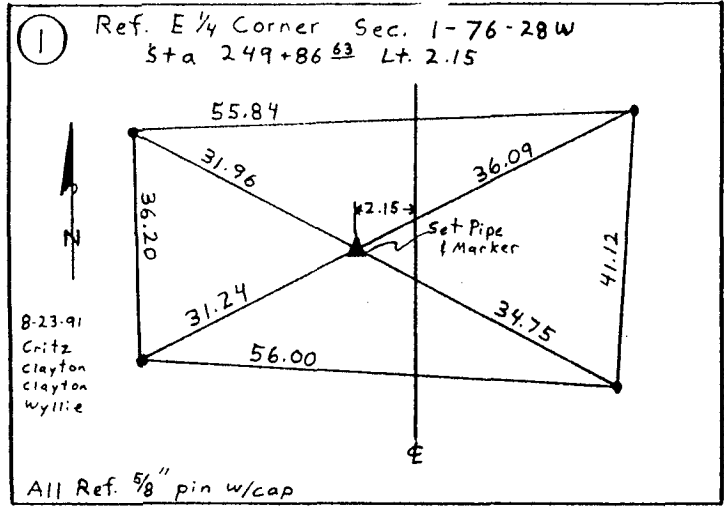

Recording Data  
 FILED NO. 90  
 BOOK 1 PAGE 98  
 92 JUL 13 AM 11:15  
 MICHELLE UTSLER  
 RECORDER  
 MADISON COUNTY, IOWA  
 Fee \$5.00

IND.   
 REC.   
 PAGE

Corner	Section	Top	Range
E 1/4	1	76	28 W
NE	1	76	28 W