SI.SI 9-90

UNITED STATES PUBLIC LAND SURVEY CORNER CERTIFICATE

OF


Land Survey Monuments situated in Section 12, Township 75 North, Range 27 West, of the Fifth Principal Meridian, MADISON County, Iowa.
Previously recorded in N/A in County Recorder's Office.
(book, page, document number, etc.)

(Show reason for preparing this certificate, the evidence and detailed procedures used in establishing the corner positions and monumentation found or placed.)


Monument Description and Remarks:

PLAN - VIEW


(Show a minimum of three reference ties to durable physical objects, relevant monuments and physical conditions that will enable recovery of the corner.)

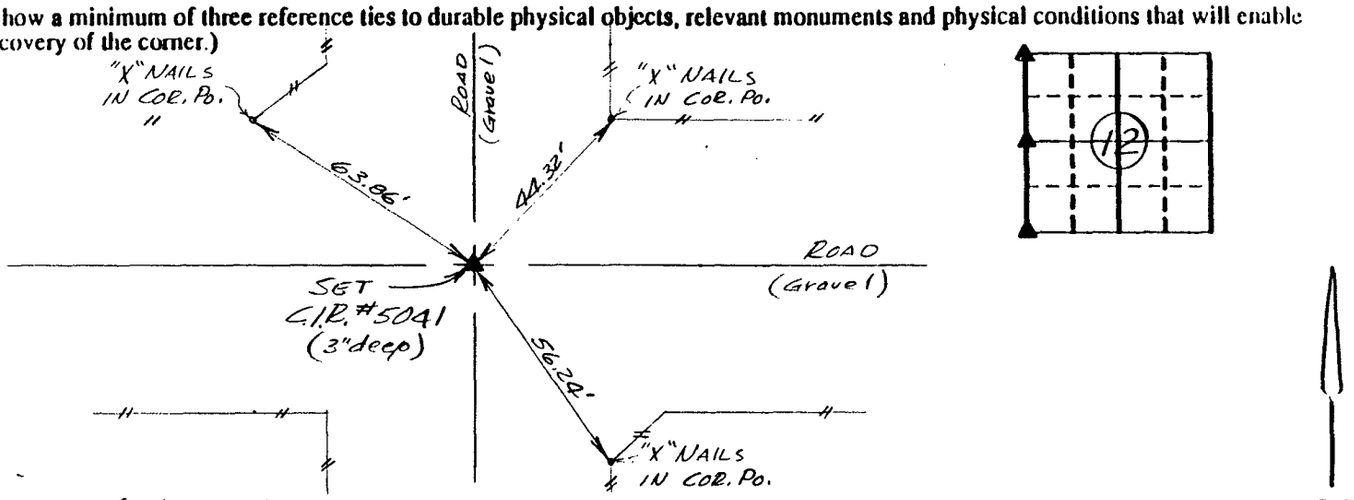

Ref. to W. 1/4 Cor., SECTION 12, T75N, R27W

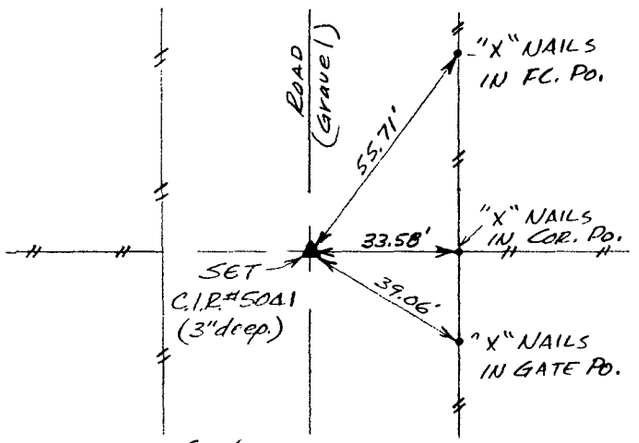

Ref. to NW. Cor., SECTION 12, T75N, R27W

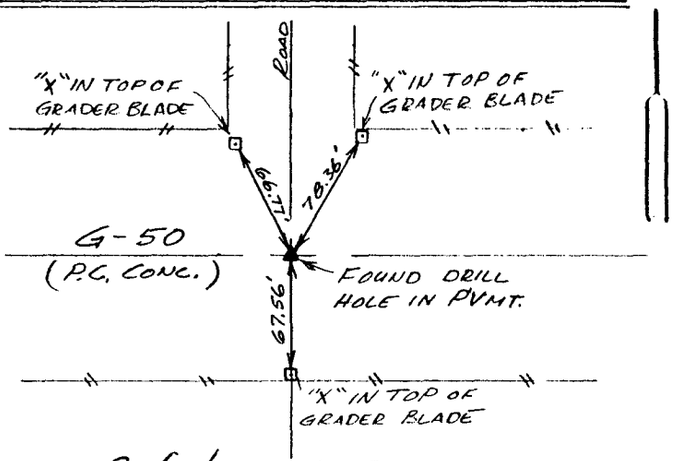

Ref. to SW. Cor., SECTION 12, T75N, R27W

I hereby certify that the survey work was completed and this certificate was prepared by me or under my direct personal supervision and that I am a duly registered land surveyor under the laws of the state of Iowa.

Signature: Charles T. Vance
Name typed or printed: Charles T. Vance, PE & LS
Date: 16 July 1992 Reg. No. 5041

PROFESSIONAL ENGINEER REGISTERED CHARLES T. VANCE 5041 IOWA LAND SURVEYOR

COMPUTER

List Corners to be Indexed

Corners	Section	Twp	Range
W. 1/4 Cor.	12	75	27
NW. Cor.	12	75	27
SW. Cor.	12	75	27

REC $ 5.00
AUD $ —
COMPARED

FILED NO. 213
BOOK 1 PAGE 106
92 JUL 28 AM 11:43
MICHELLE UTSLER
RECORDER
MADISON COUNTY, IOWA