SLSI 9-90

UNITED STATES PUBLIC LAND SURVEY CORNER CERTIFICATE

OF


Land Survey Monuments situated in Section 15, Township 75 North, Range 28 West, of the Fifth Principal Meridian, Madison County, Iowa.
Previously recorded in N/A in County Recorder's Office.
(book, page, document number, etc.)


(Show reason for preparing this certificate, the evidence and detailed procedures used in establishing the corner positions and monumentation found or placed.)

Monument Description and Remarks:

PLAN - VIEW


(Show a minimum of three reference ties to durable physical objects, relevant monuments and physical conditions that will enable recovery of the corner.)

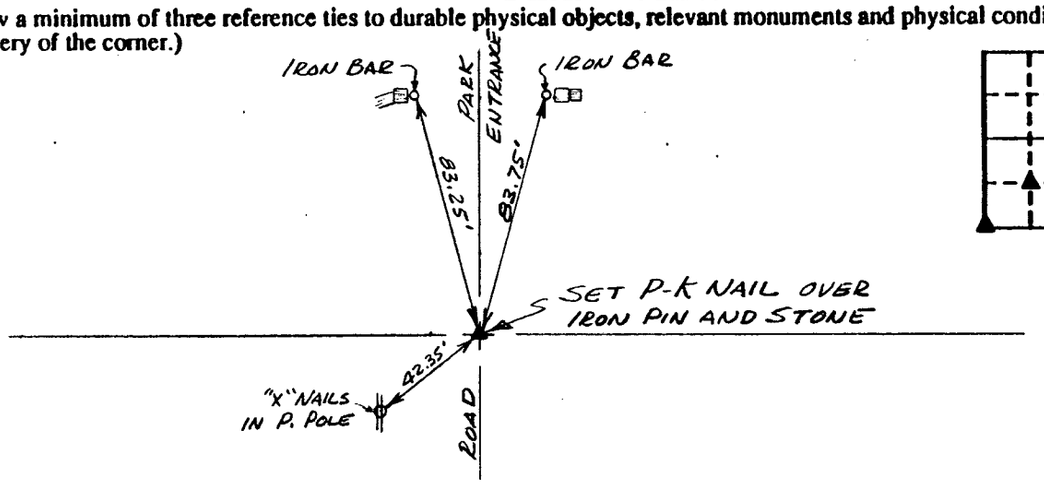

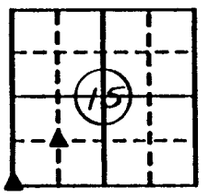

N

Ref. to SW. COR., SECTION 15, T75N, R28W.

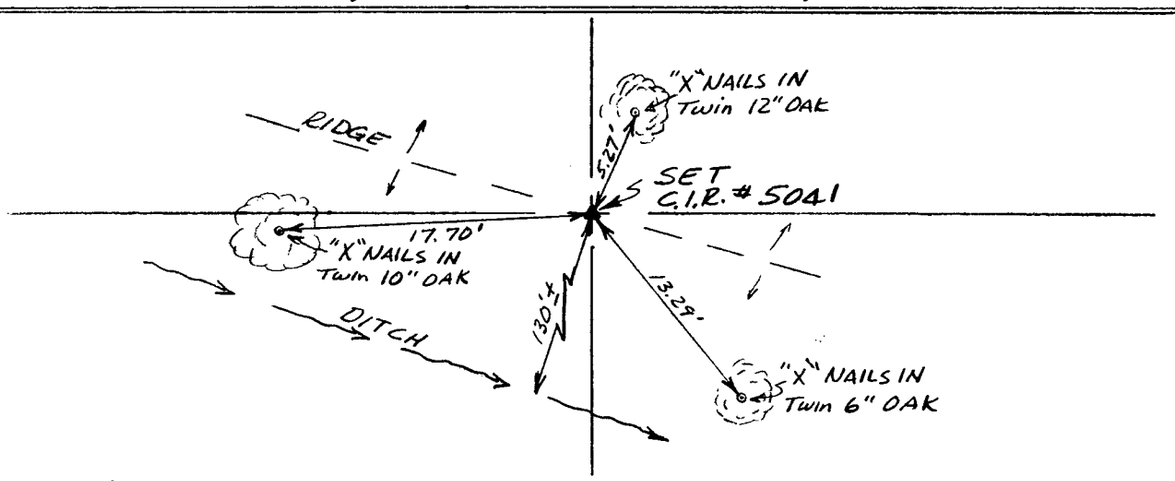

Ref. to SW. COR., NE. 1/4 SW. 1/4, SECTION 15, T75N, R28W.

I hereby certify that the survey work was completed and this certificate was prepared by me or under my direct personal supervision and that I am a duly registered land surveyor under the laws of the state of Iowa.

Signature: Charles T. Vance
Name typed or printed: Charles T. Vance, PE & LS
Date: 7 Dec. 1992 Reg. No. 5041

PROFESSIONAL ENGINEER REGISTERED SEAL CHARLES T. VANCE 5041 IOWA LAND SURVEYOR

List Corners to be Indexed

Corners	Section	Twp	Range
SW. COR.	15	75	28
SW. COR. NE. 1/4 SW. 1/4	15	75	28

COMPUTER

IND ✓
REC. ✓
PAGE ✓

FILED NO. 1572
BOOK 1 PAGE 139
92 DEC 18 PM 2:08

Fee $5.00

COMPARED

MICHELLE UTSLER
RECORDER
MADISON COUNTY, IOWA