

UNITED STATES PUBLIC LAND SURVEY CORNER CERTIFICATE

OF



Land Survey Monuments situated in Section 17, Township 74 NORTH, Range 27 WEST, of the Fifth Principal Meridian, MADISON County, Iowa.
Previously recorded in Book , Page .

(Show reason for preparing this certificate, the evidence and detailed procedures used in establishing the corner positions and monumentation found or placed.)

Monument Description and Remarks: ① SET REBAR w/ CAP # 11078 AT
CORNER POST OF INTERSECTED FENCES. ② SET REBAR
w/ CAP # 11078

PLAN - VIEW

(Show a minimum of three reference ties to durable physical objects, relevant monuments and physical conditions that will enable recovery of the corner.)

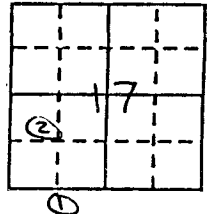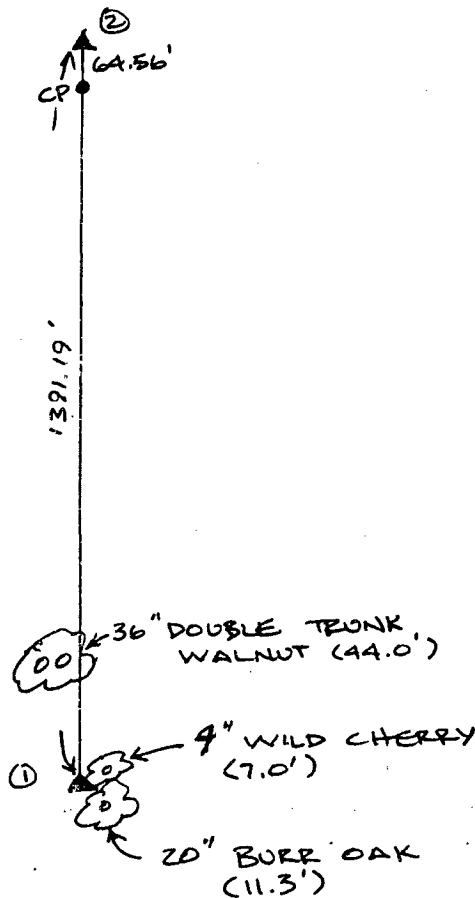


FILED NO. 2514
BOOK 1 PAGE 156
93 APR -9 AM 10:50

COMPUTER MICHELLE UTSLER
RECORDED RECORDER
MADISON COUNTY, IOWA
COMPARED Fee \$ 5.00

I hereby certify that the survey work was completed and this certificate was prepared by me or under my direct personal supervision and that I am a duly registered land surveyor under the laws of the state of Iowa.

[Signature] 2/10/93
REGISTERED LAND SURVEYOR NO. 11078

SEAL

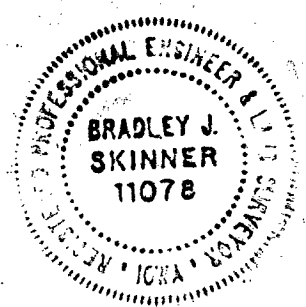

List Corners to be Indexed

Corners	Section	Twp	Range
SW $\frac{1}{4}$ SW $\frac{1}{4}$	17	74	27
NW $\frac{1}{4}$ SW $\frac{1}{4}$	17	74	27