92-1705

SLSI 9-90

UNITED STATES PUBLIC LAND SURVEY CORNER CERTIFICATE

OF


Land Survey Monuments situated in Section 34, Township 76 North, Range 26 West, of the Fifth Principal Meridian, Madison County, Iowa.
Previously recorded in N/A in County Recorder's Office.
(book, page, document number, etc.)


(Show reason for preparing this certificate, the evidence and detailed procedures used in establishing the corner positions and monumentation found or placed.)

Monument Description and Remarks: Set corners at location of best fisical and descriptive information available.

PLAN - VIEW


(Show a minimum of three reference ties to durable physical objects, relevant monuments and physical conditions that will enable recovery of the corner.)

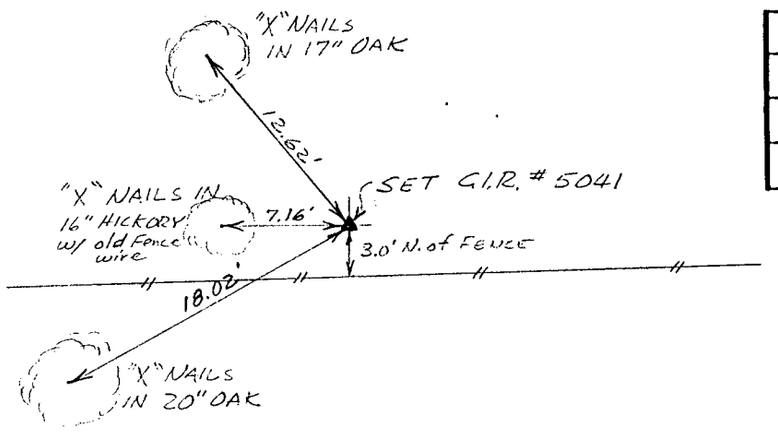

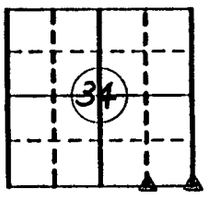

Ref. to SE. COR., SECTION 34, T76N, R26W.

N

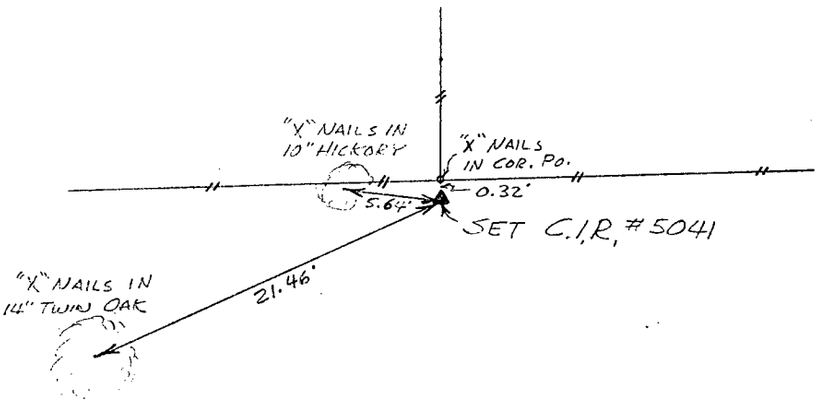

Ref. to SW. COR., SE.¼ SE.¼, SECTION 34, T76N, R26W.

I hereby certify that the survey work was completed and this certificate was prepared by me or under my direct personal supervision and that I am a duly registered land surveyor under the laws of the state of Iowa.

Signature: Charles T. Vance
Name typed or printed: Charles T. Vance, PE & LS
Date: 9 July 1993 Reg. No. 5041

SEAL — PROFESSIONAL ENGINEER — REGISTERED — CHARLES T. VANCE 5041 — IOWA — LAND SURVEYOR

List Corners to be Indexed

Corners	Section	Twp	Range
SE. COR.	34	76	26
SW. COR. SE¼ SE.¼	34	76	26

FILED NO. 129
BOOK 1 PAGE 174
93 JUL 16 AM 10: 22
COMPUTER ✓
RECORDED ✓
COMPARED ✓
Fee $6.00
MICHELLE UTSLER
RECORDER
MADISON COUNTY, IOWA