

UNITED STATES PUBLIC LAND SURVEY CORNER CERTIFICATE
OF


Land Survey Monuments situated in Section 26, Township 76 North, Range 28 West, of the Fifth Principal Meridian, Madison County, Iowa.
Previously recorded in N/A in County Recorder's Office.
(book, page, document number, etc.)

(Show reason for preparing this certificate, the evidence and detailed procedures used in establishing the corner positions and monumentation found or placed.)


Monument Description and Remarks: Set Center of Section on line between N. 1/4 Cor. and S. 1/4 Cor. and in line with fence to the West.

PLAN - VIEW

(Show a minimum of three reference ties to durable physical objects, relevant monuments and physical conditions that will enable recovery of the corner.)

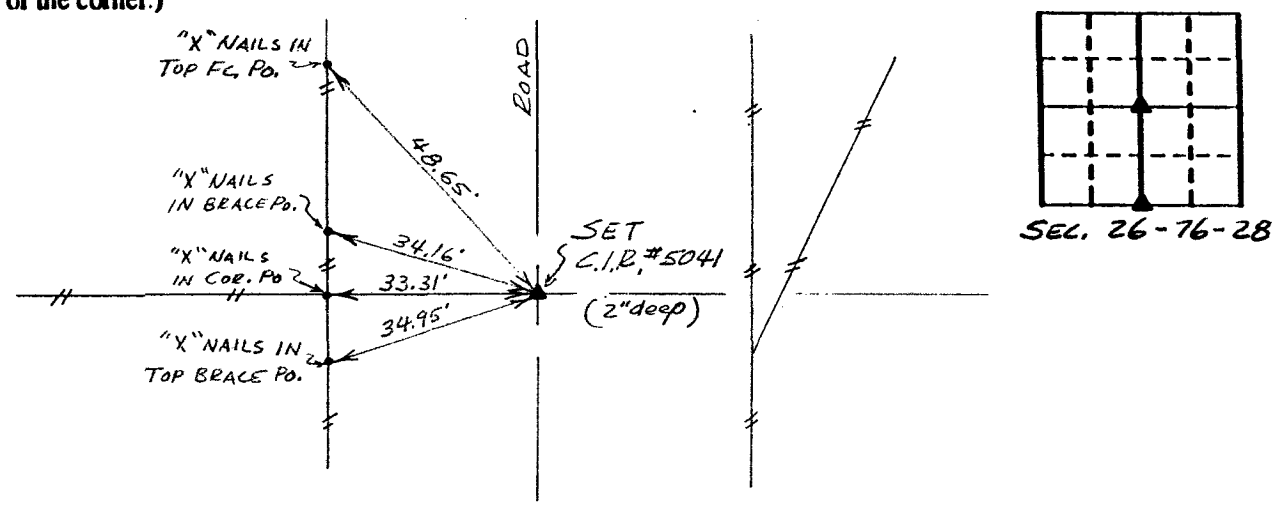

Ref. to CENTER, SECTION 26, T76N, R28W

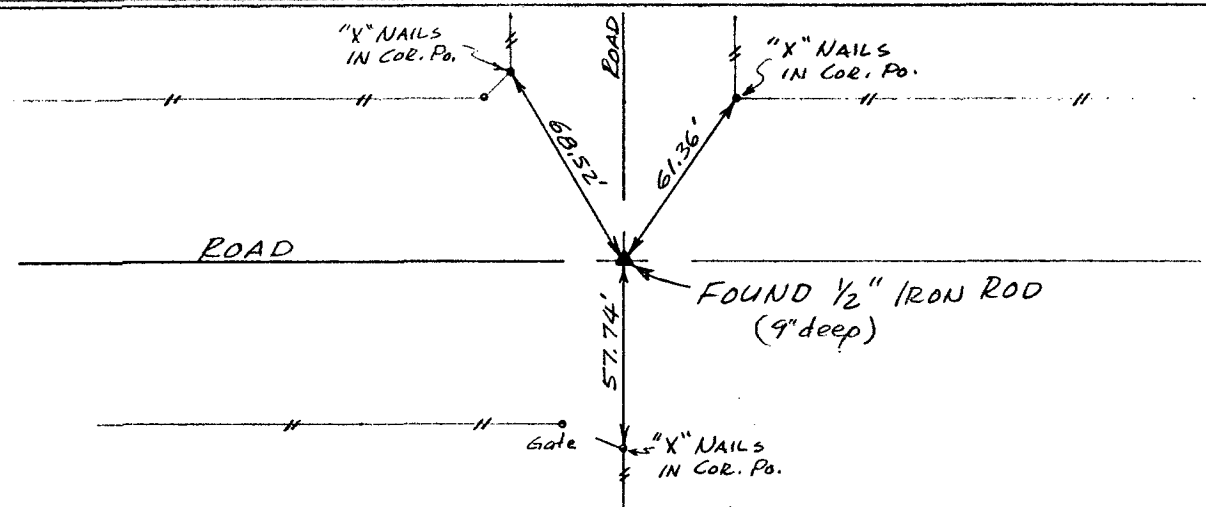


Ref. to S. 1/4 COR., SECTION 26, T76N, R28W

I hereby certify that the survey work was completed and this certificate was prepared by me or under my direct personal supervision and that I am a duly registered land surveyor under the laws of the state of Iowa.

Signature: Charles T. Vance
Name typed or printed: Charles T. Vance, PE & LS
Date: 22 April 1993 Reg. No. 5041

Corners	List Corners to be Indexed Section Twp Range
CENTER	26 - 76 - 28
S. 1/4 COR.	26 - 76 - 28

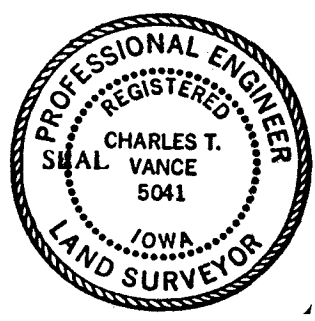

COMPUTER ☒
RECORDED ☒
COMPARED ☒

Fee \$5.00

FILED NO. 2662
BOOK 1 PAGE 161
93 APR 28 AM 9:18
MICHELLE UTSLER
RECORDER
MADISON COUNTY, IOWA