SLSI 9-90

UNITED STATES PUBLIC LAND SURVEY CORNER CERTIFICATE

OF


Land Survey Monuments situated in Section 12, Township 76 North, Range 28 West, of the Fifth Principal Meridian, Madison County, Iowa.
Previously recorded in N/A in County Recorder's Office.
(book, page, document number, etc.)

(Show reason for preparing this certificate, the evidence and detailed procedures used in establishing the corner positions and monumentation found or placed.)

Monument Description and Remarks: _____

PLAN - VIEW

(Show a minimum of three reference ties to durable physical objects, relevant monuments and physical conditions that will enable recovery of the corner.)

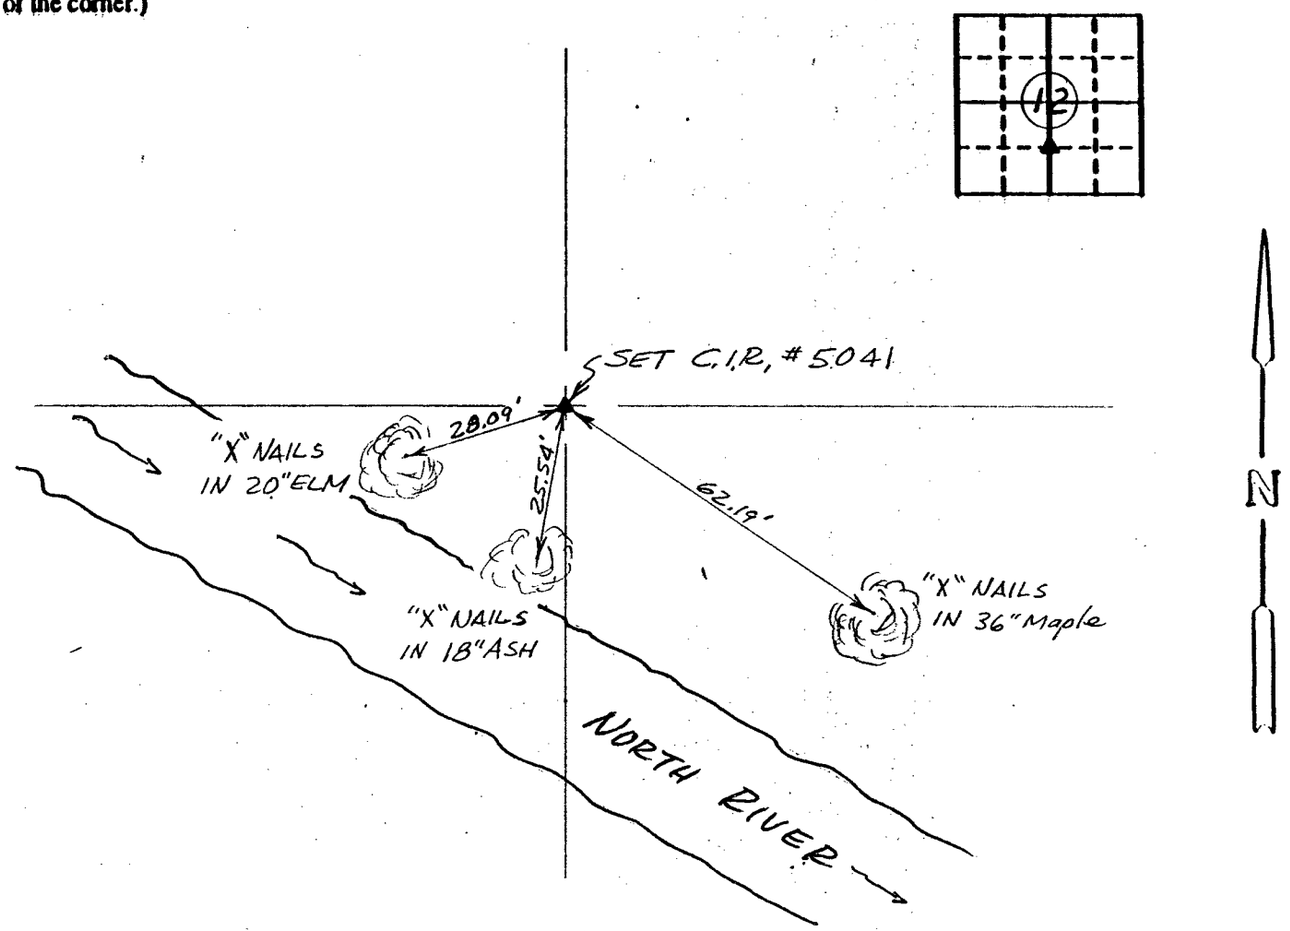

Ref. to NW. Cor., SW. 1/4 SE. 1/4, SECTION 12, T76N, R28W

I hereby certify that the survey work was completed and this certificate was prepared by me or under my direct personal supervision and that I am a duly registered land surveyor under the laws of the state of Iowa.

Signature: Charles T. Vance
Name typed or printed: Charles T. Vance, PE & LS
Date: 19 May 1993 Reg. No. 5041

SEAL — PROFESSIONAL ENGINEER — REGISTERED — CHARLES T. VANCE 5041 — IOWA — LAND SURVEYOR

COMPUTER ✓
RECORDED ✓
COMPARED ✓

List Corners to be Indexed

Corners	Section	Twp	Range
NW. Cor., SW. 1/4 SE. 1/4	12	76	28

FILED NO. 2967
Fee $5.00
BOOK 1 PAGE 170
93 MAY 25 PM 3:54
MICHELLE UTSLER
RECORDER
MADISON COUNTY, IOWA