SLSI 9-90

UNITED STATES PUBLIC LAND SURVEY CORNER CERTIFICATE 94-45

OF


Land Survey Monuments situated in Section 15, Township 74 North, Range 27 West, of the Fifth Principal Meridian, Madison County, Iowa.
Previously recorded in N/A in County Recorder's Office.
(book, page, document number, etc.)


(Show reason for preparing this certificate, the evidence and detailed procedures used in establishing the corner positions and monumentation found or placed.)

Monument Description and Remarks: Found C.I.R. #6808 at N. 1/4 Cor., and set C.I.R. #5041 by Cor. Post at W. 1/4 Cor.


PLAN - VIEW

(Show a minimum of three reference ties to durable physical objects, relevant monuments and physical conditions that will enable recovery of the corner.)

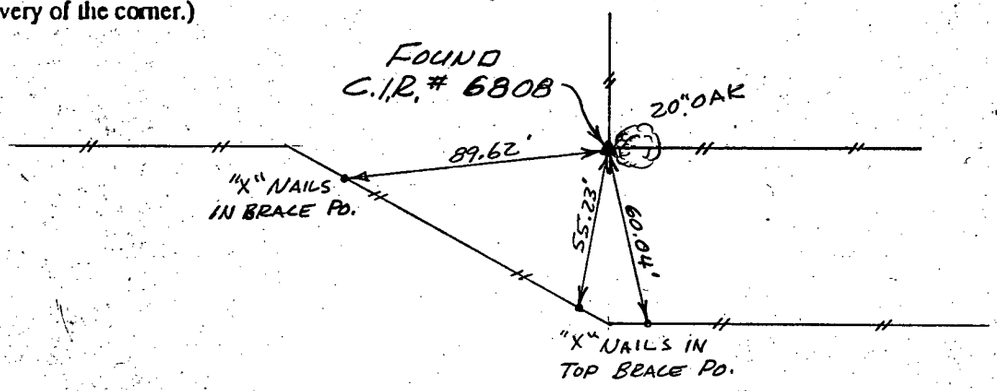


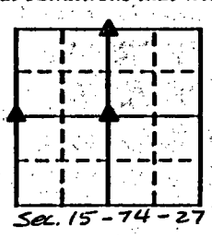

Ref. to N. 1/4 Cor., Section 15, T74N, R27W.

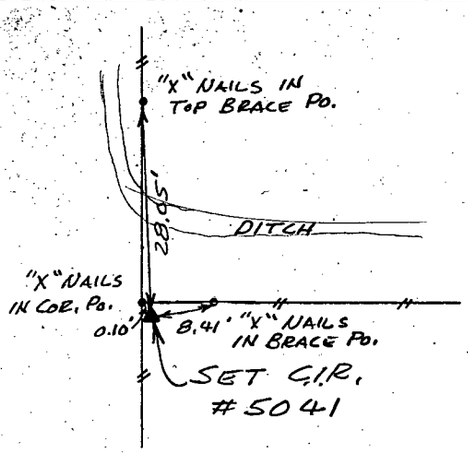

Ref. to W. 1/4 Cor., Section 15, T74N, R27W

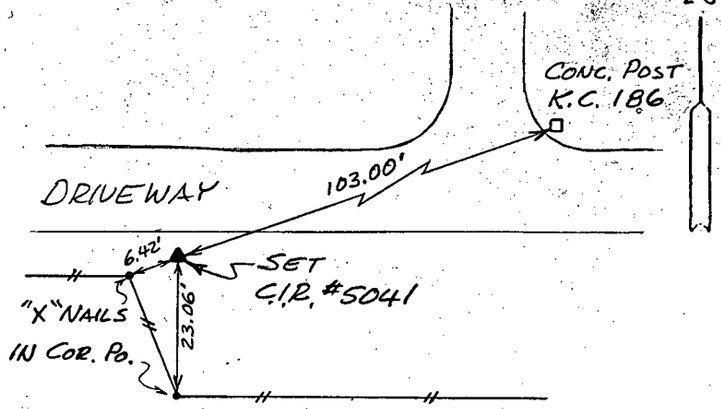

Ref. to CENTER, Section 15, T74N, R27W

I hereby certify that the survey work was completed and this certificate was prepared by me or under my direct personal supervision and that I am a duly registered land surveyor under the laws of the state of Iowa.

Signature: Charles T. Vance
Name typed or printed: Charles T. Vance, PE & LS
Date: 3 Feb. 1994 Reg. No. 5041

SEAL — PROFESSIONAL ENGINEER — REGISTERED — CHARLES T. VANCE 5041 — IOWA — LAND SURVEYOR

List Corners to be Indexed

Corners	Section	Twp	Range
N. 1/4 Cor.	15	74	27
W. 1/4 Cor.	15	74	27
Center	15	74	27

COMPUTER ✓
RECORDED ✓
COMPARED ✓

REC $ 5.00
AUD $
R.M.F. $ 1.00

FILED NO. 2241
BOOK 1 PAGE 200
94 FEB 28 AM 8:45
MICHELLE UTSLER
RECORDER
MADISON COUNTY, IOWA