SLSI 9-90

UNITED STATES PUBLIC LAND SURVEY CORNER CERTIFICATE

OF


Land Survey Monuments situated in Section 6, Township 76 North, Range 28 West, of the Fifth Principal Meridian, MADISON County, Iowa.
Previously recorded in N/A in County Recorder's Office.
(book, page, document number, etc.)


(Show reason for preparing this certificate, the evidence and detailed procedures used in establishing the corner positions and monumentation found or placed.)

Monument Description and Remarks:

PLAN - VIEW


(Show a minimum of three reference ties to durable physical objects, relevant monuments and physical conditions that will enable recovery of the corner.)

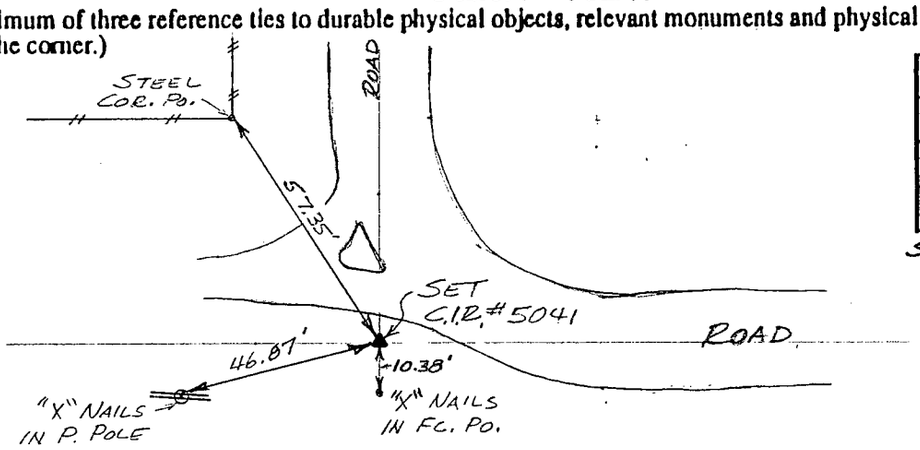

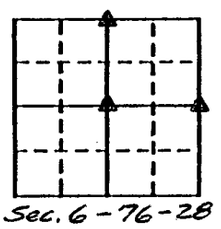


N

Ref. to CENTER OF SECTION 6, T76N, R28W

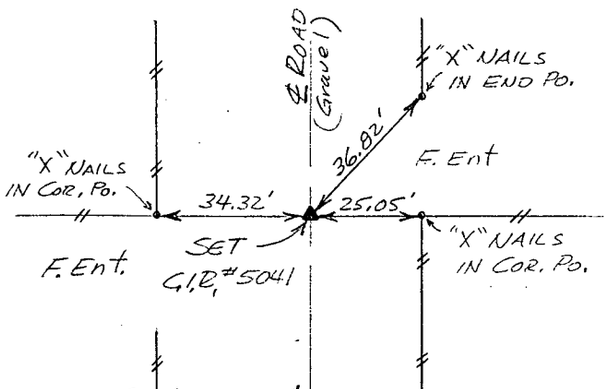

Ref. to N. 1/4 Cor.
SECTION 6, T76N, R28W

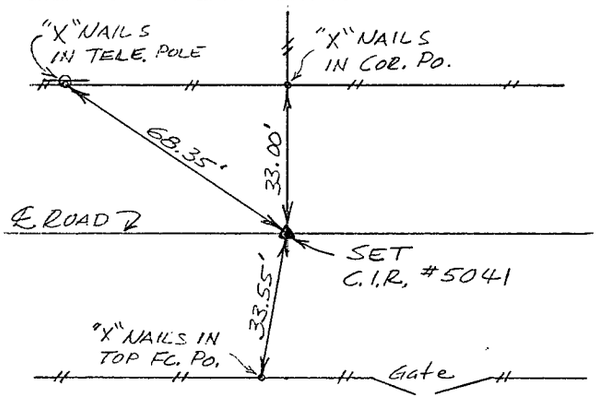

Ref. to E. 1/4 Cor.
SECTION 6, T76N, R28W

I hereby certify that the survey work was completed and this certificate was prepared by me or under my direct personal supervision and that I am a duly registered land surveyor under the laws of the state of Iowa.

Signature: Charles T Vance
Name typed or printed: Charles T. Vance, PE & LS
Date: 11 July 1994 Reg. No. 5041
94-955

SEAL: PROFESSIONAL ENGINEER REGISTERED CHARLES T. VANCE 5041 IOWA LAND SURVEYOR

List Corners to be Indexed

Corners	Section	Twp	Range
CENTER	6	76	28
N. 1/4 Cor.	6	76	28
E. 1/4 Cor.	6	76	28

REC $ 5.00
AUD $
R.M.F. $ 1.00

COMPUTER ✓
RECORDED ✓
COMPARED ✓

FILED NO. 319
BOOK 1 PAGE 233
94 AUG -2 PM 1:51
MICHELLE UTSLER
RECORDER
MADISON COUNTY, IOWA