

UNITED STATES PUBLIC LAND SURVEY CORNER CERTIFICATE

OF

Land Survey Monuments situated in Section 33, Township 76 N, Range 33 W, of the Fifth Principal Meridian, Madison County, Iowa.
Previously recorded in N/A in County Recorder's Office.



(Show reason for preparing this certificate, the evidence and detailed procedures used in establishing the corner positions and monumentation found or placed.)

Monument Description and Remarks: found capped Iron rod #5041 2" deep

PLAN - VIEW

(Show a minimum of three reference ties to durable physical objects, relevant monuments and physical conditions that will enable recovery of the corner.)

N 1/4 corner Sec. 33-T76N-R28W

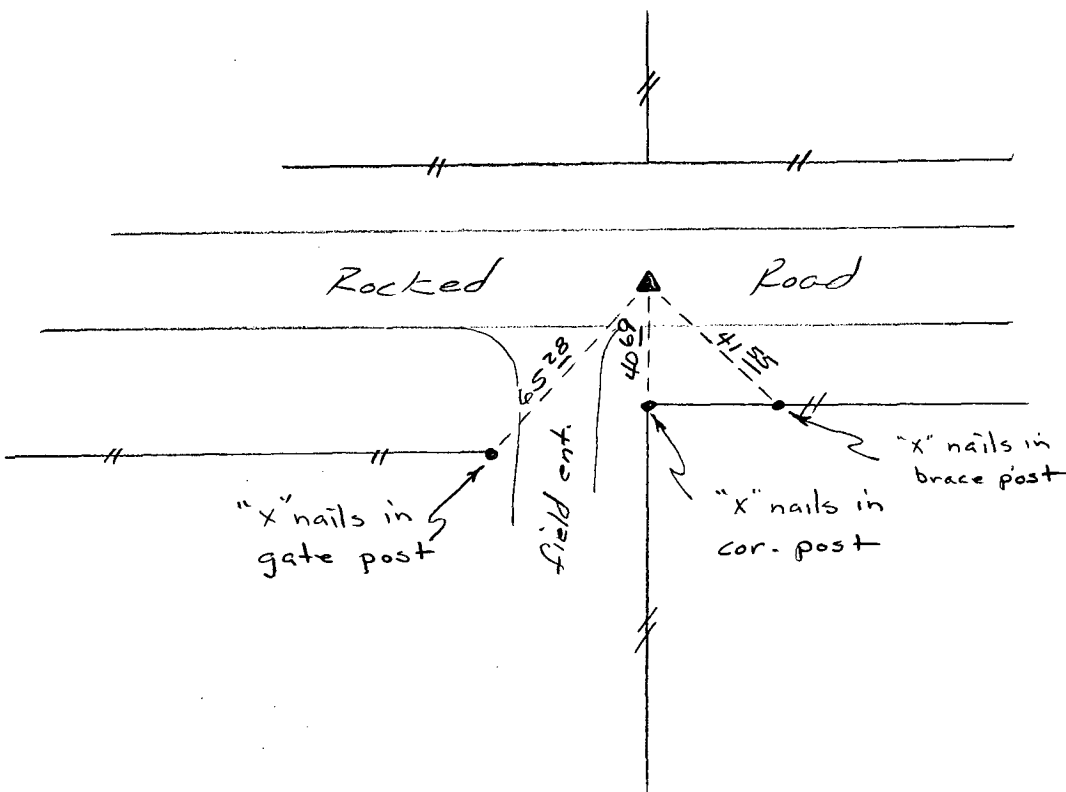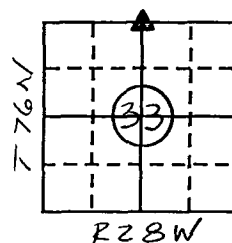

I hereby certify that the survey work was completed and this land surveying document was prepared by me or under my direct personal supervision and that I am a duly registered land surveyor under the laws of the state of Iowa

Signature: J. M. Hochstetler
Name typed or printed: J. M. Hochstetler

Date: 1/30/95 Reg. No. 6808

My registration renewal date is December 31, 1995

SEAL



Corners	List Corners to be Indexed Section	Twp	Range
N. 1/4 cor.	33	T76N	R28W

COMPUTER
RECORDED
COMPARED

REC \$ 5.00
AUD \$
R.M.F. \$ 1.00

FILED NO. 1946

BOOK 1 PAGE 262

95 JAN 30 PM 2:42

MICHELLE UTSLER
RECORDER
MADISON COUNTY, IOWA