

UNITED STATES PUBLIC LAND SURVEY CORNER CERTIFICATE

94-1795

OF

Land Survey Monuments situated in Section 2, Township 77 North, Range 28 West, of the Fifth Principal Meridian, MADISON County, Iowa.
 Previously recorded in N/A in County Recorder's Office.


(book, page, document number, etc.)

(Show reason for preparing this certificate, the evidence and detailed procedures used in establishing the corner positions and monumentation found or placed.)

Monument Description and Remarks: Set C.I.R. #5041 at E split of
county road right of way and in line with property
fence lines both North and South.

PLAN - VIEW

(Show a minimum of three reference ties to durable physical objects, relevant monuments and physical conditions that will enable recovery of the corner.)

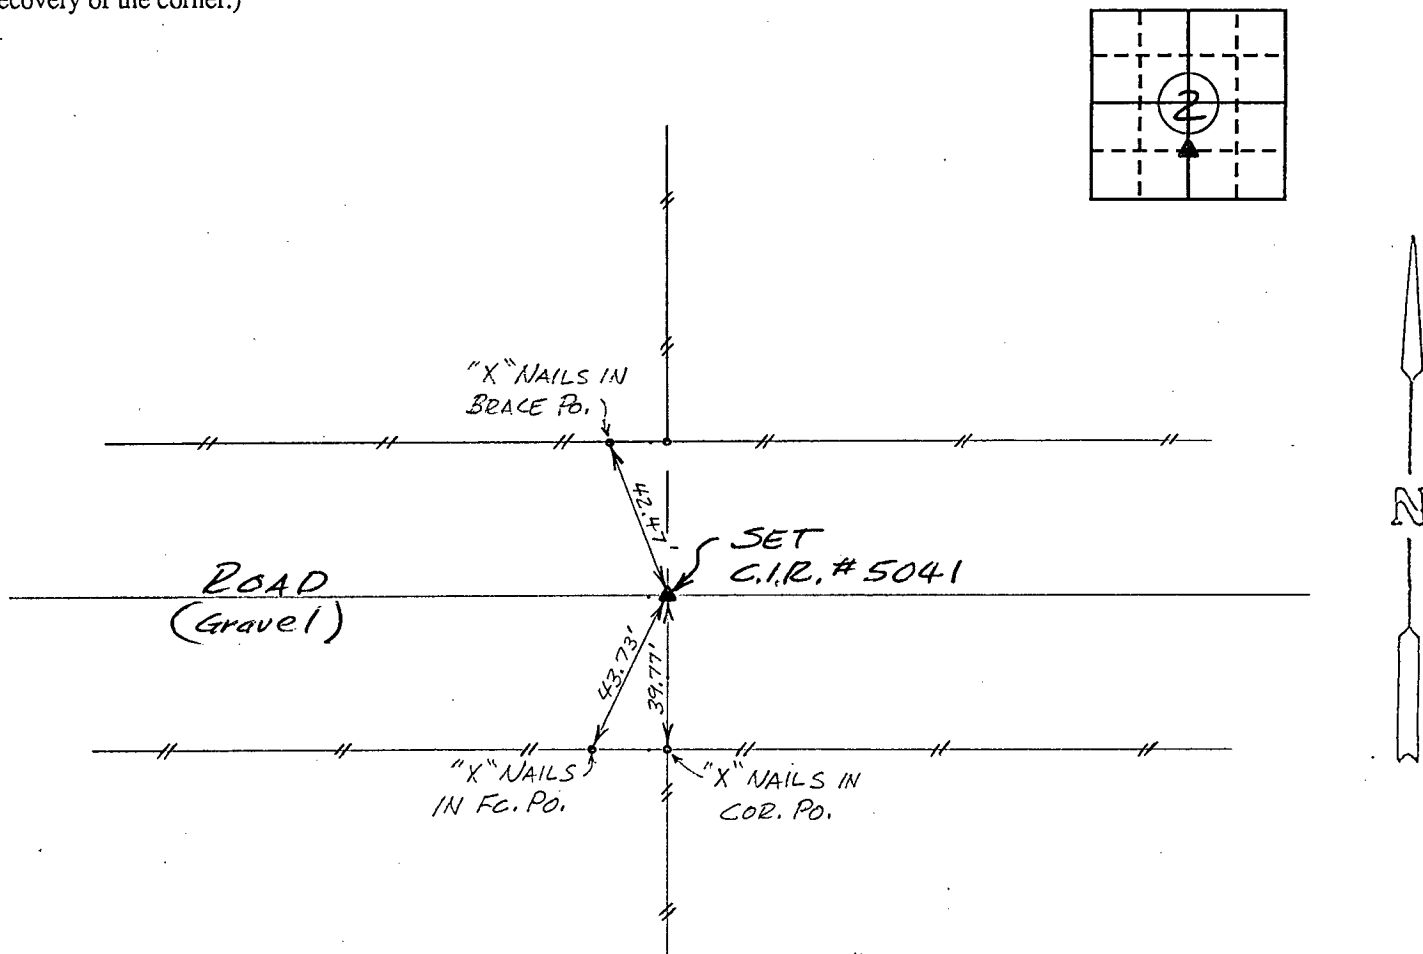


Ref. to NE. COR., SE. $\frac{1}{4}$ SW. $\frac{1}{4}$, SECTION 2, T77N, R28W.

I hereby certify that the survey work was completed and this land surveying document was prepared by me or under my direct personal supervision and that I am a duly registered land surveyor under the laws of the state of Iowa

Signature: Charles T. Vance
 Name typed or printed: Charles T. Vance, PE & LS

Date: 10 Nov. 1994 Reg. No. 5041

My registration renewal date is December 31, 19 95

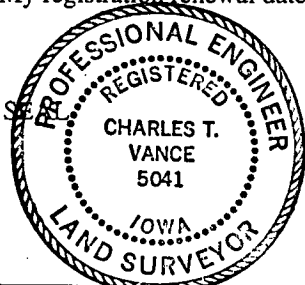COMPUTER ☒RECORDED ☒COMPARED ☒

Corners List Corners to be Indexed
 Section Twp Range

NE. COR
 SE. $\frac{1}{4}$ SW. $\frac{1}{4}$ 2 - 77 - 28

FILED NO. 1513

BOOK 1 PAGE 253

94 DEC -6 PM 2:01

MICHELLE UTSLER
 RECORDER
 MADISON COUNTY, IOWA

REC \$ 5.00AUD \$ 1.00R.M.F. \$ 1.00