

UNITED STATES PUBLIC LAND SURVEY CORNER CERTIFICATE

OF

Land Survey Monuments situated in Section 17, Township 74 NORTH, Range 27 WEST, of the Fifth Principal Meridian, MADISON County, Iowa.
Previously recorded in Book , Page .



(Show reason for preparing this certificate, the evidence and detailed procedures used in establishing the corner positions and monumentation found or placed.)

Monument Description and Remarks: SET REBAR PER ORIGINAL ROAD

EASEMENT DESCRIPTIONS

PLAN - VIEW


(Show a minimum of three reference ties to durable physical objects, relevant monuments and physical conditions that will enable recovery of the corner.)

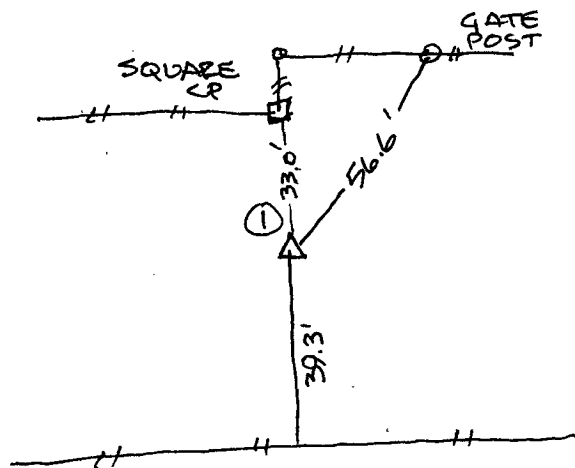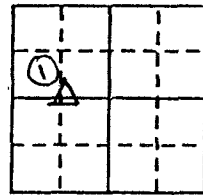

I hereby certify that the survey work was completed and this certificate was prepared by me or under my direct personal supervision and that I am a duly registered land surveyor under the laws of the state of Iowa.

[Signature] 5/4/94
REGISTERED LAND SURVEYOR NO. 11078

SEAL

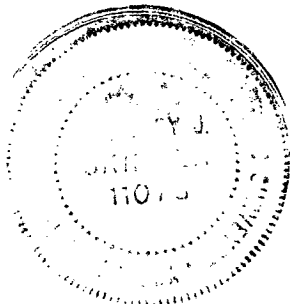

List Corners to be Indexed

Corners	Section	Twp	Range
NW	17	74	27
NE $\frac{1}{4}$ SW $\frac{1}{4}$			

REC \$ 500
AUD \$
R.M.F. \$ 100

FILED NO. 1721
BOOK 1 PAGE 256

95 JAN - 3 AM 11:15

COMPUTER
RECORDED
COMPARED

MICHELLE UTSLER
RECORDER
MADISON COUNTY, IOWA