SLSI 9-94

UNITED STATES PUBLIC LAND SURVEY CORNER CERTIFICATE

94-2195

OF


Land Survey Monuments situated in Section 9, Township 74 North, Range 28 West, of the Fifth Principal Meridian, Madison County, Iowa.
Previously recorded in N/A in County Recorder's Office.
(book, page, document number, etc.)


(Show reason for preparing this certificate, the evidence and detailed procedures used in establishing the corner positions and monumentation found or placed.)

Monument Description and Remarks: Set C.I.R.#5041 at the W. 1/4 COR.
Used ref. ties from County Engineer to determine location of Cor.

PLAN - VIEW


(Show a minimum of three reference ties to durable physical objects, relevant monuments and physical conditions that will enable recovery of the corner.)

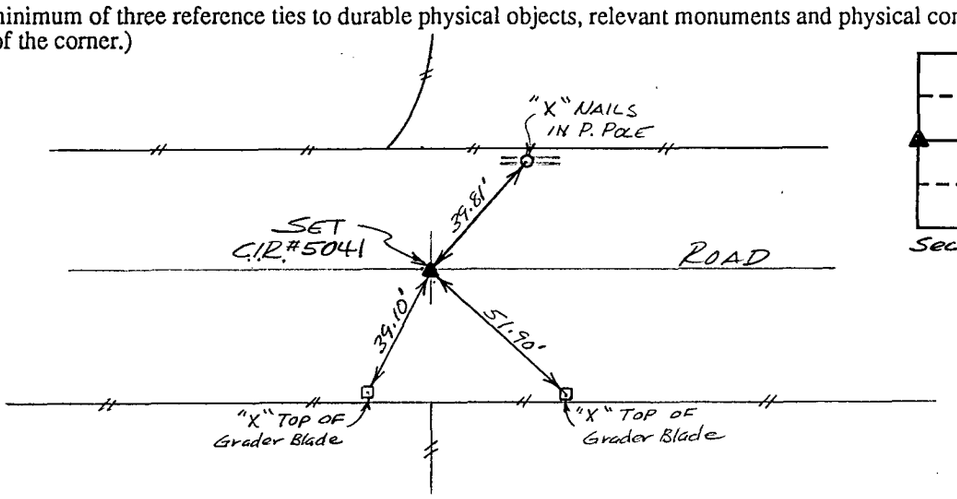

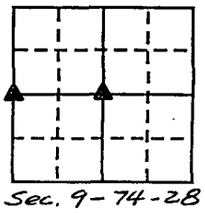

N

Ref. to the W. 1/4 COR. of SECTION 9, T74N, R28W

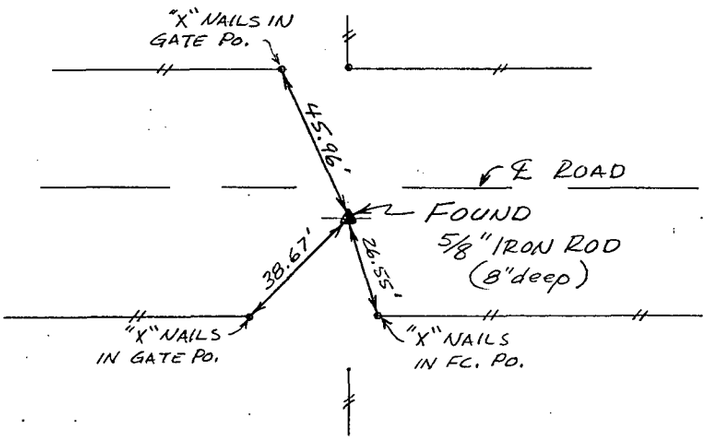

Ref. to the CENTER of SECTION 9, T74N, R28W.

I hereby certify that the survey work was completed and this land surveying document was prepared by me or under my direct personal supervision and that I am a duly registered land surveyor under the laws of the state of Iowa


Signature: Charles T. Vance

Name typed or printed: Charles T. Vance, PE & LS

Date: 12 Jan 1995 Reg. No. 5041

My registration renewal date is December 31, 1995

SEAL

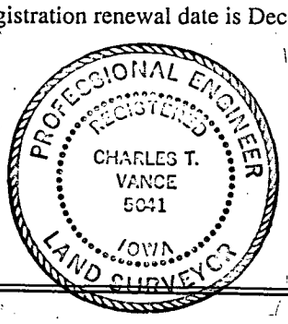

List Corners to be Indexed

Corners	Section	Twp	Range
W. 1/4 COR.	9	74	28
CENTER	9	74	28

REC $ 5.00
AUD $
R.M.F. $ 1.00

COMPUTER ✓
RECORDED ✓
COMPARED

FILED NO. 1920
BOOK 1 PAGE 260
95 JAN 26 AM 9:54
MICHELLE UTSLER
RECORDER
MADISON COUNTY, IOWA