

UNITED STATES PUBLIC LAND SURVEY CORNER CERTIFICATE

94-2095

OF

Land Survey Monuments situated in Section 15, Township 7.4 North, Range 26 West, of the Fifth Principal Meridian, Madison County, Iowa. Previously recorded in N/A in County Recorder's Office.


(book, page, document number, etc.)

(Show reason for preparing this certificate, the evidence and detailed procedures used in establishing the corner positions and monumentation found or placed.)

Monument Description and Remarks: see sketch below

PLAN - VIEW

(Show a minimum of three reference ties to durable physical objects, relevant monuments and physical conditions that will enable recovery of the corner.)

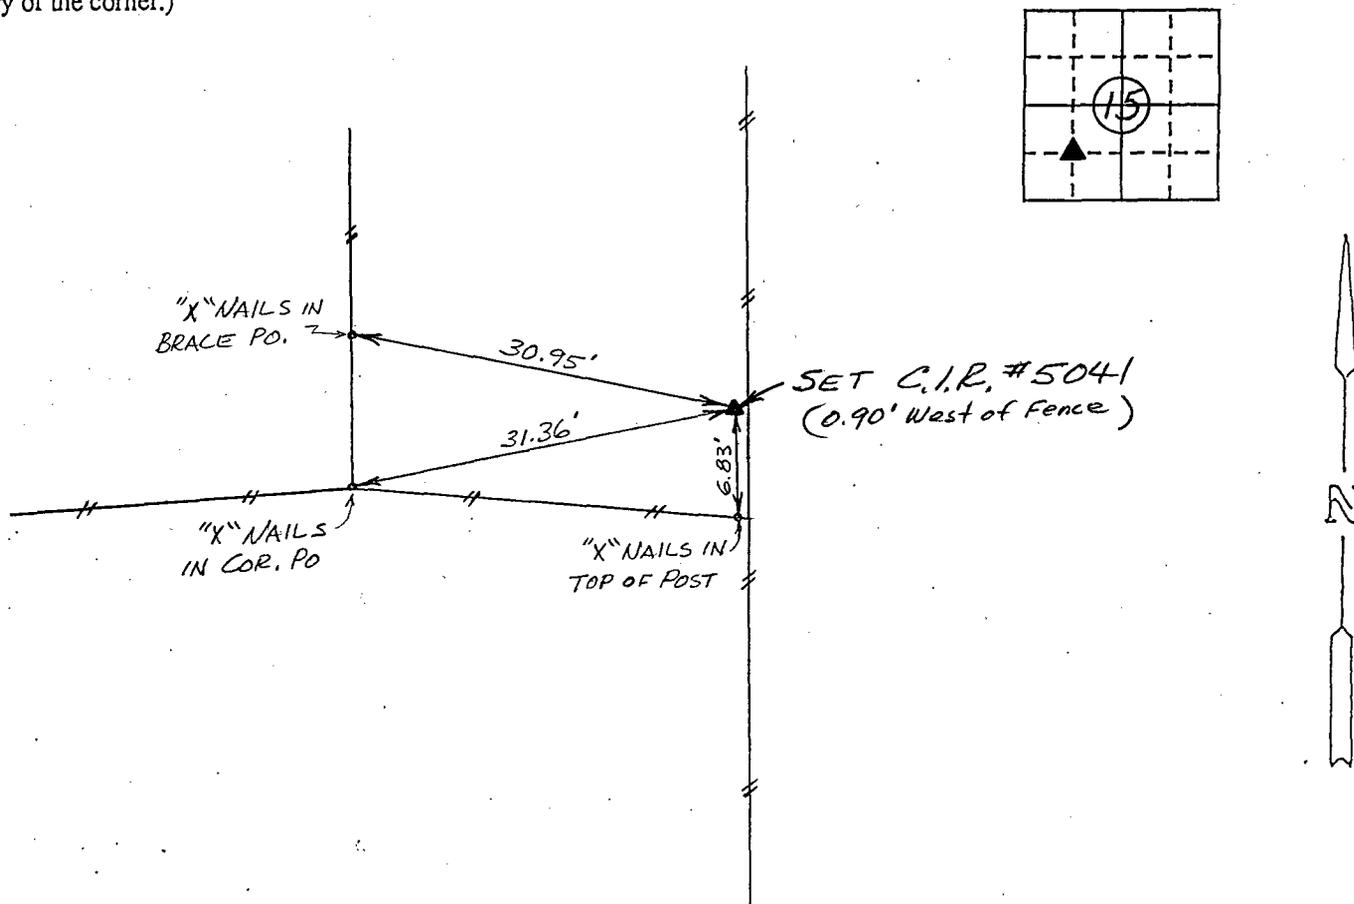


Ref. to NE. COR., SW. 1/4 SW. 1/4, SECTION 15, T74N, R26W.

I hereby certify that the survey work was completed and this land surveying document was prepared by me or under my direct personal supervision and that I am a duly registered land surveyor under the laws of the state of Iowa

Signature: Charles T. Vance
Name typed or printed: Charles T. Vance, PE & LS

Date: 28 Feb. 1995 Reg. No. 5041

My registration renewal date is December 31, 1995

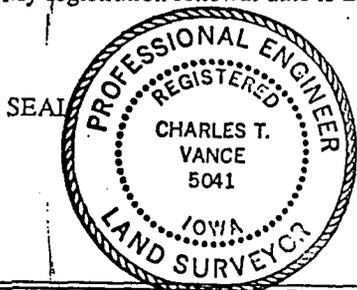

Corners	Section	Twp	Range
NE. COR.	15	74	26
SW. 1/4 SW. 1/4			

REC \$ 5.00
AUD \$
R.M.F. \$ 1.00

COMPUTER
RECORDED
COMPARED

FILED NO. 2443
BOOK 1 PAGE 274

95 MAR 28 PM 2:09
MICHELLE UTSLER
RECORDER
MADISON COUNTY, IOWA