

REC. \$ 5.00
R.M.F. \$ 1.00

FILED NO. 2678
BOOK 1 PAGE 353
96 APR -2 PM 2:02
MICHELLE UTSLER
RECORDER
MADISON COUNTY, IOWA

CHECKED
INDEXED
CORRECTED

Prepared By: J. Brian Morrissey, Morrissey Surveying, 1926 Pammel Park Road, Winterset, Ia. 50273, Tele. (515) 462-2166

UNITED STATES PUBLIC LAND SURVEY CORNER CERTIFICATE
OF



Land Survey Monuments situated in Section 2, Township 75 N, Range 28 W, of the Fifth Principal Meridian, Madison County, Iowa.
Previously recorded in Book 1, Page 6 in County Recorders Office.
(book,page,document number,etc.)

(Show reason for preparing this certificate, the evidence and detailed procedures used in establishing the corner positions and monumentation found or placed.)

Monument Description and Remarks: Found lead plug in pavement previously tied by the IDOT. Ties varied from IDOT Section Corner Certificate.

PLAN VIEW

(Show a minimum of three reference ties to durable physical objects, relevant monuments and physical conditions that will enable recovery of the corner.)

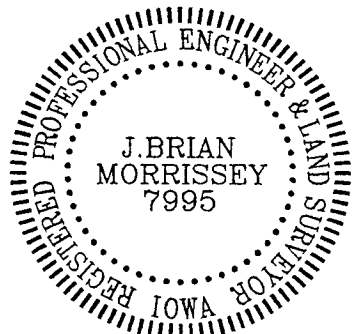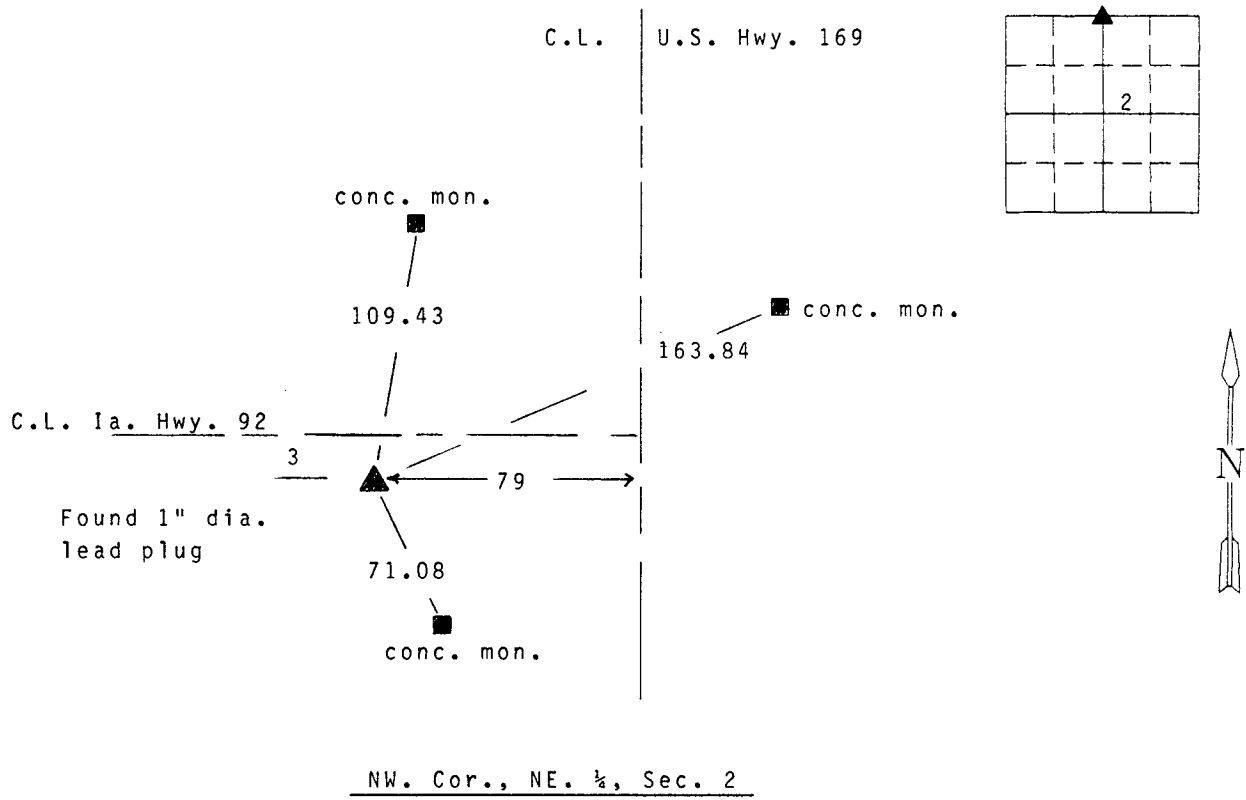

I hereby certify that the survey work was completed and this certificate was prepared by me or my direct personal supervision and that I am a duly registered land surveyor under the laws of the state of Iowa. My registration renewal date is 12/31/97.
Signature: J. Brian Morrissey
Name typed or printed: J. Brian Morrissey
Date: 4/2/96 Reg.No. 7995 129-96