96-435

REC $ 5.00
AUD $
R.M.F. $ 1.00

COMPUTER ✓
RECORDED ✓
COMPARED ✓

FILED NO. 3530
BOOK 1 PAGE 377
96 JUN 13 PM 3:34
MICHELLE UTSLER
RECORDER
MADISON COUNTY, IOWA

VANCE & HOCHSTETLER, P.C. CONSULTING ENGINEERS, WINTERSET, IOWA (515)462-3995
CHARLES T. VANCE, 71 JEFFERSON ST., WINTERSET, IOWA 50273
JAMES M. HOCHSTETLER, 71 JEFFERSON ST., WINTERSET, IOWA 50273

SLSI 9-94

UNITED STATES PUBLIC LAND SURVEY CORNER CERTIFICATE

OF

Land Survey Monuments situated in Section 6, Township 74 NORTH, Range 27 WEST, of the Fifth Principal Meridian, MADISON County, Iowa.
Previously recorded in _____ (book, page, document number, etc.) in County Recorder's Office.


(Show reason for preparing this certificate, the evidence and detailed procedures used in establishing the corner positions and monumentation found or placed.)

Monument Description and Remarks:

NE cor. NW 1/4 NE 1/4 - Set PK nail in pavement on split of N. line NE 1/4.
SE cor. NW 1/4 NE 1/4 - Set CIR #6808 @ fence split

PLAN - VIEW

(Show a minimum of three reference ties to durable physical objects, relevant monuments and physical conditions that will enable recovery of the corner.)

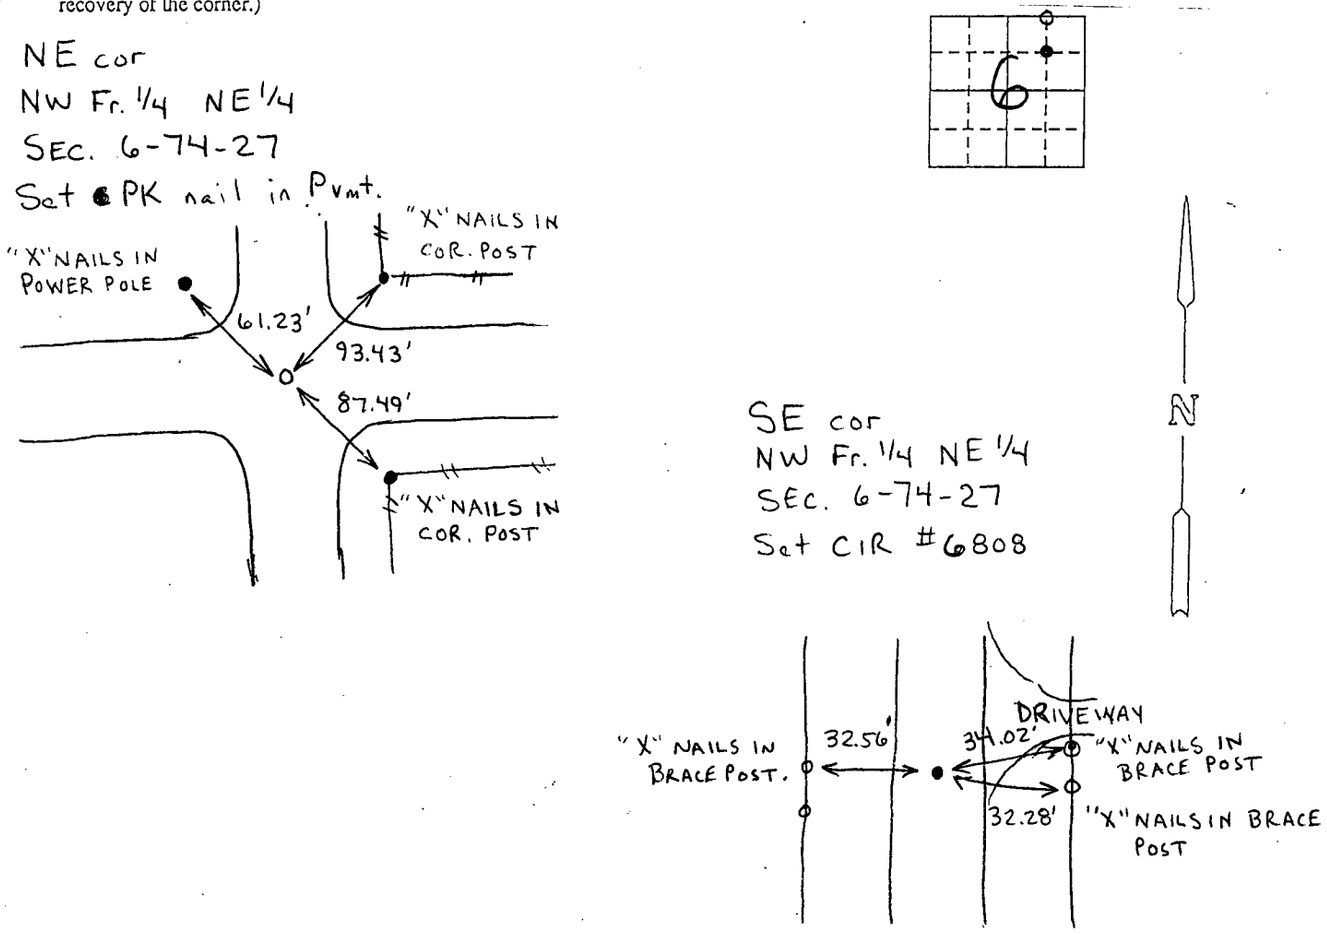

I hereby certify that the survey work was completed and this land surveying document was prepared by me or under my direct personal supervision and that I am a duly registered land surveyor under the laws of the state of Iowa

Signature: J.M. Hochstetler
Name typed or printed: J.M. Hochstetler

Date: 5/31/96 Reg. No. 6808

My registration renewal date is December 31, 1997

SEAL

PROFESSIONAL REGISTERED J.M. HOCHSTETLER 6808 IOWA LAND SURVEYOR

List Corners to be Indexed

Corners	Section	Twp	Range
NE cor NW 1/4 NE 1/4	6	74N	27W
SE cor NW 1/4 NE 1/4	6	74N	27W