

REC \$ 5.00AUD. R.M.F. 1.00COMPUTER ✓RECORDED ✓COMPARED ✓FILED NO. **2993**BOOK 1 PAGE 368

96 MAY -1 PM 3:02

MICHELLE UTSLER
RECORDER
MADISON COUNTY, IOWA

Prepared By: J. Brian Morrissey, Morrissey Surveying, 1926 Pammel Park Road, Winterset, Ia. 50273, Tele. (515) 462-2166

UNITED STATES PUBLIC LAND SURVEY CORNER CERTIFICATE
OFLand Survey Monuments situated in Section 1, Township 75 N, Range 27 W, of the Fifth Principal Meridian, Madison County, Iowa.
Previously recorded in N.A. in County Recorders Office.

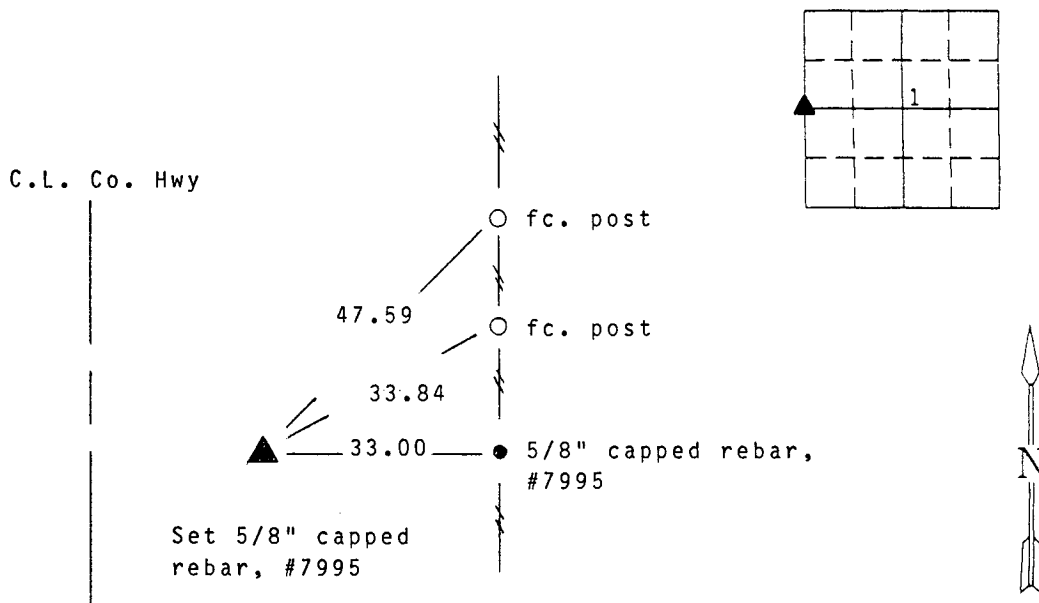
(book, page, document number, etc.)

(Show reason for preparing this certificate, the evidence and detailed procedures used in establishing the corner positions and monumentation found or placed.)

Monument Description and Remarks: Set 5/8" capped rebar, #7995, at 20 chains single proportionate measure S. from NW. Corner, SW. 1/4, NW. 1/4. Position of monument of survey recorded Farm Plat Book 2, Page 423 not accepted. Monument set for said recorded survey not found. Position of set monument also based on found Section Corners along W. line of Section.

PLAN VIEW

(Show a minimum of three reference ties to durable physical objects, relevant monuments and physical conditions that will enable recovery of the corner.)

NW. Cor., SW. 1/4, Sec. 1

Note: all ties to "x" nails unless noted



I hereby certify that the survey work was completed and this certificate was prepared by me or my direct personal supervision and that I am a duly registered land surveyor under the laws of the state of Iowa. My registration renewal date is 12/31/97.

Signature: J. Brian Morrissey

Name typed or printed: J. Brian Morrissey

Date: 5/1/96 Reg. No. 7995

131-96