COMPUTER ✓
[illegible] ✓
[illegible] ✓

FILED NO. 67
BOOK 1 PAGE 393

96 JUL -9 AM 11: 17

REC $ 5.00
AUD $
R.M.F. $ 1.00

MICHELLE UTSLER
RECORDER
MADISON COUNTY, IOWA

VANCE & HOCHSTETLER, P.C. CONSULTING ENGINEERS, WINTERSET, IOWA (515)462-3995
CHARLES T. VANCE, 71 JEFFERSON ST., WINTERSET, IOWA 50273
JAMES M. HOCHSTETLER, 71 JEFFERSON ST., WINTERSET, IOWA 50273

SLSI 9-94

UNITED STATES PUBLIC LAND SURVEY CORNER CERTIFICATE

OF

Land Survey Monuments situated in Section 11, Township 77 NORTH, Range 26 WEST, of the Fifth Principal Meridian, MADISON County, Iowa.
Previously recorded in _____ in County Recorder's Office.
(book, page, document number, etc.)

(Show reason for preparing this certificate, the evidence and detailed procedures used in establishing the corner positions and monumentation found or placed.)

Monument Description and Remarks:


SE corner SW 1/4 SW 1/4 - Cut "X" in centerline of County Rd. G-4R on split of south line of the SW 1/4 of Section 11.


WEST 1/4 corner - Set CIR # 6808 at fence corner


NE corner NW 1/4 SW 1/4 - Found CIR # 5041 at fence corner

PLAN - VIEW


(Show a minimum of three reference ties to durable physical objects, relevant monuments and physical conditions that will enable recovery of the corner.)

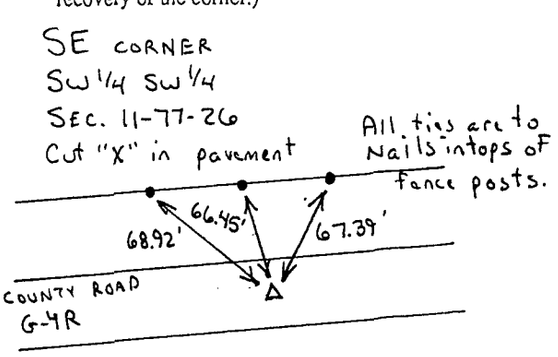

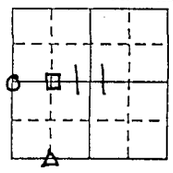

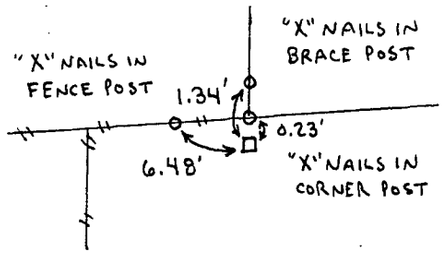



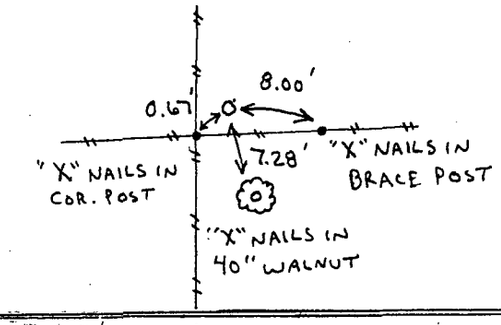

I hereby certify that the survey work was completed and this land surveying document was prepared by me or under my direct personal supervision and that I am a duly registered land surveyor under the laws of the state of Iowa.

Signature: J M Hochstetler
Name typed or printed: J. M. Hochstetler

Date: 6/18/96 Reg. No. 6808

My registration renewal date is December 31, 1997

SEAL

PROFESSIONAL REGISTERED J.M. HOCHSTETLER 6808 IOWA LAND SURVEYOR

List Corners to be Indexed

Corners	Section	Twp	Range
SE corner △ SW 1/4 SW 1/4	11	77N	26W
WEST 1/4 cor. ○	11	77N	26W
NE corner □ NW 1/4 SW 1/4	11	77N	26W