96-1133

COMPUTER ✓
RECORDED ✓
COMPARED ✓

REC'D $ 5.00
A.U.D. $
R.M.F. $ 1.00

FILED NO. 331
BOOK 1 PAGE 397
96 AUG -2 PM 12: 02
MICHELLE UTSLER
RECORDER
MADISON COUNTY, IOWA

VANCE & HOCHSTETLER, P.C. CONSULTING ENGINEERS, WINTERSET, IOWA (515)462-3995
CHARLES T. VANCE, 71 JEFFERSON ST., WINTERSET, IOWA 50273
JAMES M. HOCHSTETLER, 71 JEFFERSON ST., WINTERSET, IOWA 50273

SLSI 9-94

UNITED STATES PUBLIC LAND SURVEY CORNER CERTIFICATE

OF

Land Survey Monuments situated in Section 1, Township 74 NORTH, Range 26 WEST, of the Fifth Principal Meridian, MADISON County, Iowa.
Previously recorded in _____ in County Recorder's Office.
(book, page, document number, etc.)

(Show reason for preparing this certificate, the evidence and detailed procedures used in establishing the corner positions and monumentation found or placed.)


Monument Description and Remarks:

WEST 1/4 corner - Set CIR #6808 at ROW fence split at property fence.


NE corner NW 1/4 SW 1/4 - Set CIR #6808 at Fence corner

PLAN - VIEW


(Show a minimum of three reference ties to durable physical objects, relevant monuments and physical conditions that will enable recovery of the corner.)

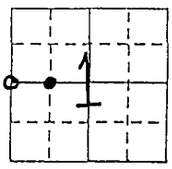

WEST 1/4 COR.
SEC. 1-74-26
Set CIR #6808

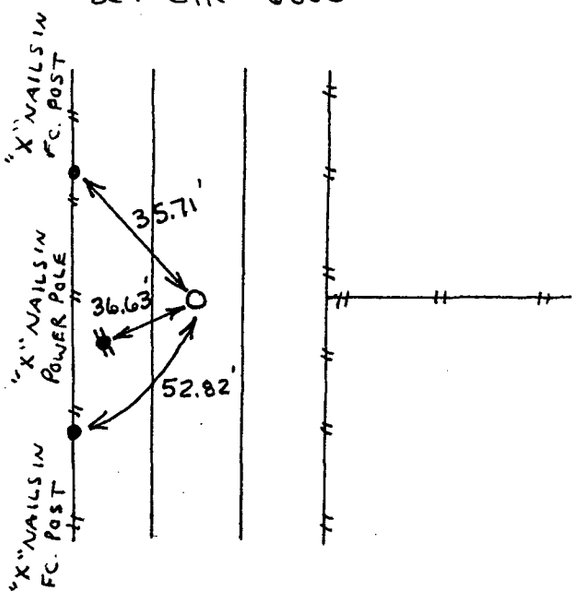

NE CORNER
NW 1/4 SW 1/4
SEC. 1-74-26
Set CIR #6808

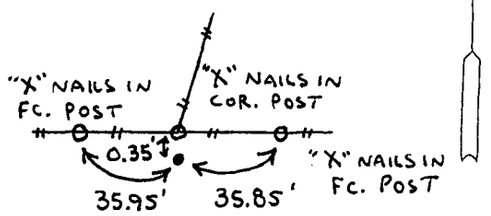

I hereby certify that the survey work was completed and this land surveying document was prepared by me or under my direct personal supervision and that I am a duly registered land surveyor under the laws of the state of Iowa

Signature: J. M. Hochstetler
Name typed or printed: J. M. Hochstetler
Date: 7/30/96 Reg. No. 6808
My registration renewal date is December 31, 1997

SEAL

PROFESSIONAL REGISTERED J.M. HOCHSTETLER 6808 IOWA LAND SURVEYOR

List Corners to be Indexed

Corners	Section	Twp	Range
WEST 1/4 cor.	1	74 N	26 W
NE cor. NW 1/4 SW 1/4	1	74 N	26 W