COMPUTER ✓
RECORDED ✓
COMPARED ✓

FILED NO. 63
BOOK 1 PAGE 389

96 JUL -9 AM 11: 11

REC $ 5.00
AUD $
R.M.F. $ 1.00

MICHELLE UTSLER
RECORDER
MADISON COUNTY, IOWA

VANCE & HOCHSTETLER, P.C. CONSULTING ENGINEERS, WINTERSET, IOWA (515)462-3995
CHARLES T. VANCE, 71 JEFFERSON ST., WINTERSET, IOWA 50273
JAMES M. HOCHSTETLER, 71 JEFFERSON ST., WINTERSET, IOWA 50273

SLSI 9-94

UNITED STATES PUBLIC LAND SURVEY CORNER CERTIFICATE

OF


Land Survey Monuments situated in Section 2, Township 74 N, Range 26 W, of the Fifth Principal Meridian, MADISON County, Iowa.
Previously recorded in _____ (book, page, document number, etc.) in County Recorder's Office.


(Show reason for preparing this certificate, the evidence and detailed procedures used in establishing the corner positions and monumentation found or placed.)


Monument Description and Remarks: N¼ Cor. - Found 60d" Nail 4" Deep in Rock Road in line with P/L. Fence to North
SE Cor NE¼ NW¼ - Set CIR #6808 at Corner Post OF P/L Fence TO EAST.
NW Cor NE¼ NW¼ - Set CIR #6808 at ℄ County Road in Line with P/L. Fence to North.


PLAN - VIEW

(Show a minimum of three reference ties to durable physical objects, relevant monuments and physical conditions that will enable recovery of the corner.)

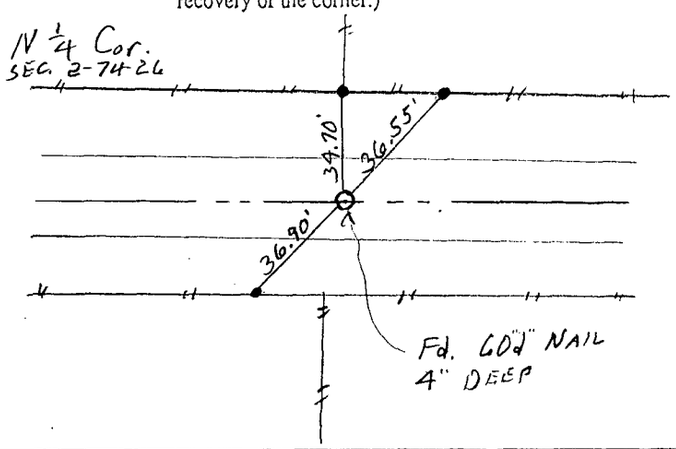

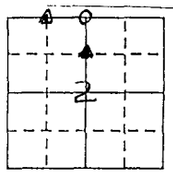

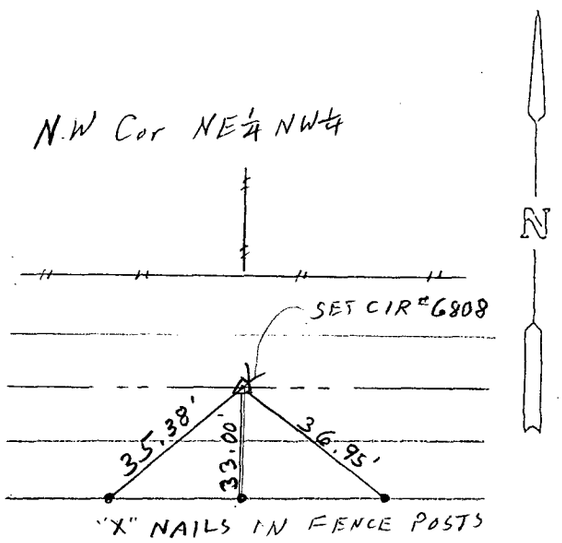

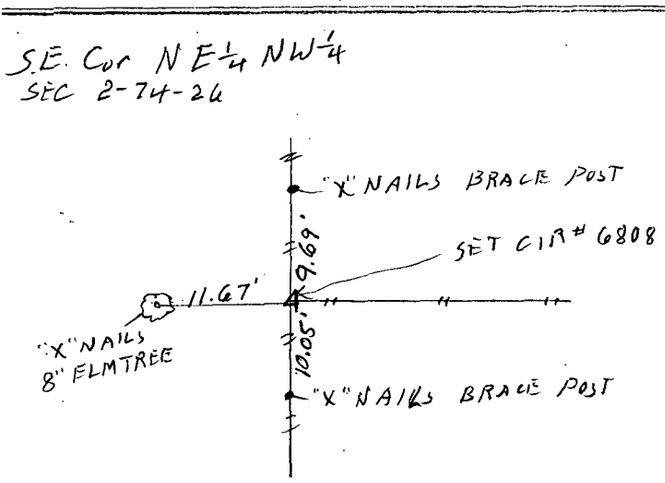

I hereby certify that the survey work was completed and this land surveying document was prepared by me or under my direct personal supervision and that I am a duly registered land surveyor under the laws of the state of Iowa

Signature: J.M. Hochstetler
Name typed or printed: J.M. Hochstetler

Date: 6/21/96 Reg. No. 6808

My registration renewal date is December 31, 1997

SEAL

PROFESSIONAL REGISTERED J.M. HOCHSTETLER 6808 IOWA LAND SURVEYOR

List Corners to be Indexed

Corners	Section	Twp	Range
N¼ Cor	2	74N	26W
NW Cor NE¼NW¼	2	74N	26W
SE Cor. NE¼ NW¼	2	74N	26W