

REC 5 02

96 JUL -9 AM 11:13

AUD
R.M.F. 5 1 00MICHELLE UTSLER
RECORDER
MADISON COUNTY, IOWA

VANCE & HOCHSTETLER, P.C. CONSULTING ENGINEERS, WINTERSET, IOWA (515)462-3995

CHARLES T. VANCE, 71 JEFFERSON ST., WINTERSET, IOWA 50273

JAMES M. HOCHSTETLER, 71 JEFFERSON ST., WINTERSET, IOWA 50273

SLSI 9-94

UNITED STATES PUBLIC LAND SURVEY CORNER CERTIFICATE

OF

Land Survey Monuments situated in Section 15, Township 76 NORTH, Range 26 WEST, of the Fifth Principal Meridian, MADISON County, Iowa.
Previously recorded in N/A in County Recorder's Office.

(book, page, document number, etc.)

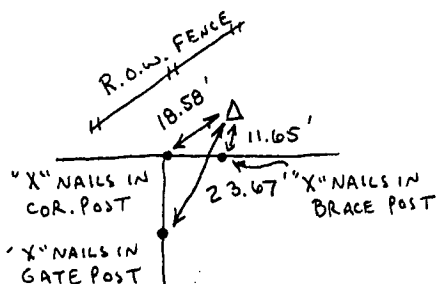
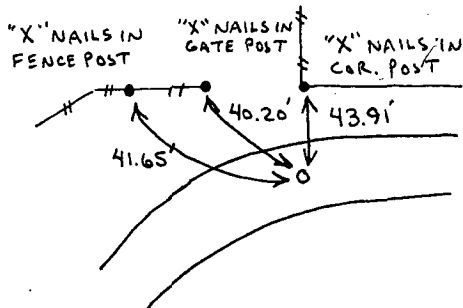
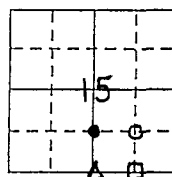
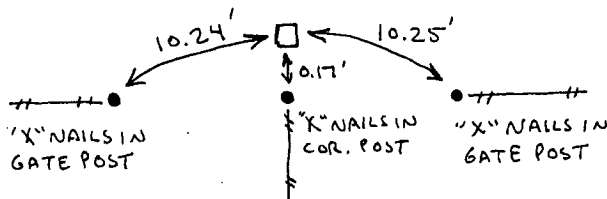
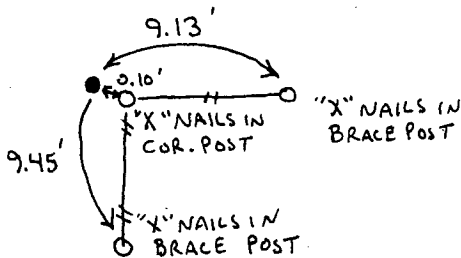
(Show reason for preparing this certificate, the evidence and detailed procedures used in establishing the corner positions and monumentation found or placed.)

Monument Description and Remarks:

NE corner SW 1/4 SE 1/4 - Set CIR #5041 to replace RR spike lost during grading.SOUTH 1/4 corner - Found CIR #5041NW corner SW 1/4 SE 1/4 - Found CIR #5041SE corner SW 1/4 SE 1/4 - Set CIR #5041 at fence corner. (3-way).

PLAN - VIEW

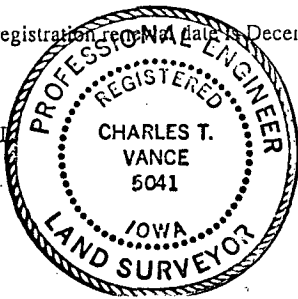
(Show a minimum of three reference ties to durable physical objects, relevant monuments and physical conditions that will enable recovery of the corner.)

NE cor
SW 1/4 SE 1/4
SEC. 15-76-26
Set CIR #5041SOUTH 1/4 cor.
SEC. 15-76-26
Fd. CIR #5041NW CORNER
SW 1/4 SE 1/4
SEC. 15-76-26
Fd. CIR #5041SE CORNER
SW 1/4 SE 1/4
SEC. 15-76-26
Set CIR #5041

I hereby certify that the survey work was completed and this land surveying document was prepared by me or under my direct personal supervision and that I am a duly registered land surveyor under the laws of the state of Iowa

Signature: Charles T. VanceName typed or printed: Charles T. VanceDate: 13 June 1996 Reg. No. 5041My registration expires on December 31, 1997

SEAL



List Corners to be Indexed

Corners	Section	Twp	Range
NE cor SW 1/4 SE 1/4	15	76 N	26 W
S 1/4 cor. Δ	15	76 N	26 W
NW cor. ●	15	76 N	26 W
SW 1/4 SE 1/4	15	76 N	26 W
SE cor. □	15	76 N	26 W
SW 1/4 SE 1/4	15	76 N	26 W