

REC \$5.00
AUD \$
R.M.F. \$1.00

96-1265
FILED NO. 573
BOOK 1 PAGE 408

COMPUTER
RECORDED
COMPARED

96 AUG 27 PM 4:18
MICHELLE UTSLER
RECORDER
MADISON COUNTY, IOWA

VANCE & HOCHSTETLER, P.C. CONSULTING ENGINEERS, WINTERSSET, IOWA (515) 462-3995

CHARLES T. VANCE, 110 West Green St., Winterset, Iowa 50273
JAMES M. HOCHSTETLER, 110 West Green St., Winterset, Iowa 50273

SLSI 9-94

UNITED STATES PUBLIC LAND SURVEY CORNER CERTIFICATE

OF

Land Survey Monuments situated in Section 14, Township 75 NORTH, Range 29 WEST, of the Fifth Principal Meridian, MADISON County, Iowa.
Previously recorded in _____ in County Recorder's Office.

(book, page, document number, etc.)

(Show reason for preparing this certificate, the evidence and detailed procedures used in establishing the corner positions and monumentation found or placed.)


Monument Description and Remarks:

CENTER- Set CIR #6808 at R.O.W. fence split at property line fence to North
NW corner NE 1/4 SE 1/4 - Set CIR #6808 at East-West split
EAST 1/4 cor. - Cut "X" in bridge deck.


PLAN - VIEW

(Show a minimum of three reference ties to durable physical objects, relevant monuments and physical conditions that will enable recovery of the corner.)


CENTER
SEC. 14-75-29
Set CIR #6808

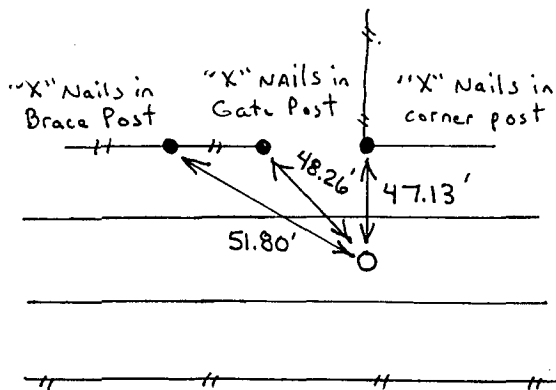

EAST 1/4 cor.
SEC. 14-75-29
Cut "X" in bridge deck

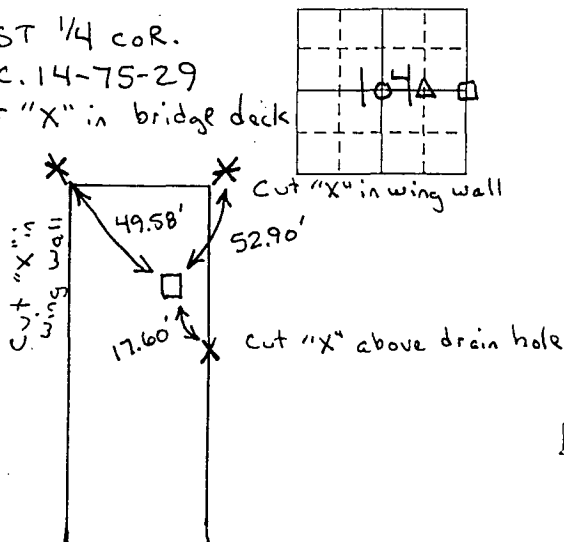

NW corner
NE 1/4 SE 1/4
SEC. 14-75-29
Set CIR #6808

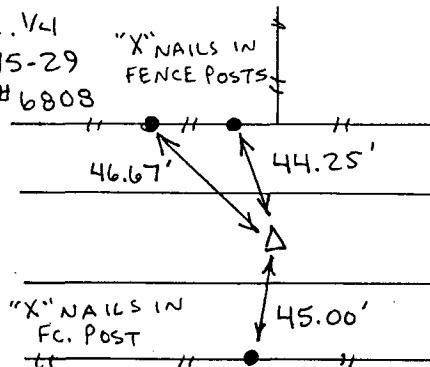

I hereby certify that the survey work was completed and this land surveying document was prepared by me or under my direct personal supervision and that I am a duly registered land surveyor under the laws of the state of Iowa

Signature: J.M. Hochstetler
Name typed or printed: J.M. Hochstetler

Date: 8/23/96 Reg. No. 6808

My registration renewal date is December 31, 1997

List Corners to be Indexed

Corners	Section	Twp	Range
CENTER	14	75N	29W
NW cor			
NE 1/4 SE 1/4	14	75N	29W
EAST 1/4 cor.	14	75N	29W



SEAL