96-1225

REC $ 5.00
AUD $
R.M.F. $ 1.00

FILED NO. 574
BOOK 1 PAGE 409
96 AUG 27 PM 4:21
MICHELLE UTSLER
RECORDER
MADISON COUNTY, IOWA

COMPUTER ✓
RECORDED ✓
COMPARED ✓

VANCE & HOCHSTETLER, P.C. CONSULTING ENGINEERS, WINTERSET, IOWA (515)462-3995
CHARLES T. VANCE, 110 West Green St., Winterset, Iowa 50273
JAMES M. HOCHSTETLER, 110 West Green St., Winterset, Iowa 50273

SLSI 9-94

UNITED STATES PUBLIC LAND SURVEY CORNER CERTIFICATE

OF

Land Survey Monuments situated in Section 6, Township 76 N, Range 26 W, of the Fifth Principal Meridian, MADISON County, Iowa.
Previously recorded in _____ (book, page, document number, etc.) in County Recorder's Office.

(Show reason for preparing this certificate, the evidence and detailed procedures used in establishing the corner positions and monumentation found or placed.)


Monument Description and Remarks: S.W. Corner found CIR #5041 set in April 1990 as the NE Corner Section 12-T76N-R27W for survey in Section 12 and Section 1 of T76N-R27W.
W¼ Corner Section 6 set CIR #6808 in line with property line fence east and split of West Road ROW fence and old ROW fence North of Corner


PLAN - VIEW


(Show a minimum of three reference ties to durable physical objects, relevant monuments and physical conditions that will enable recovery of the corner.)

W¼ COR
SEC. 6-76-26
SET CIR # 6808

S.W. COR
SEC. 6-76-26
FOUND CIR # 5041

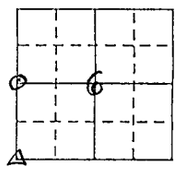

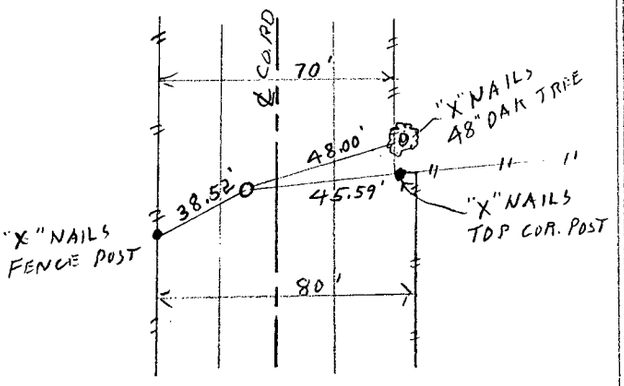

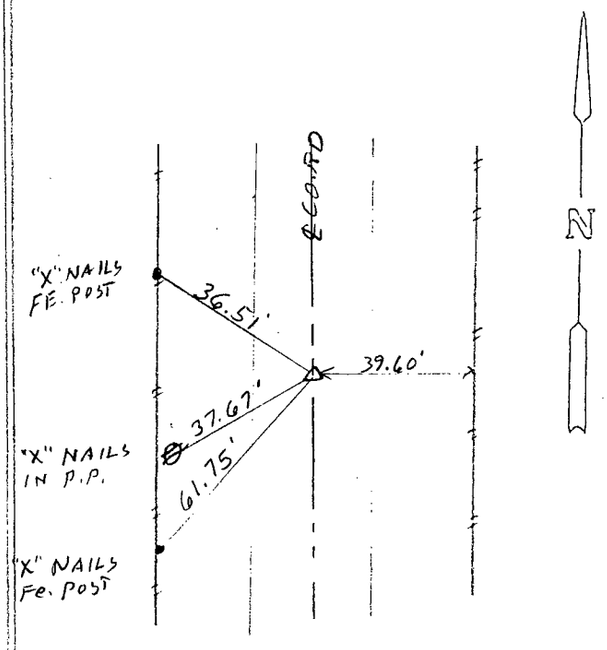

I hereby certify that the survey work was completed and this land surveying document was prepared by me or under my direct personal supervision and that I am a duly registered land surveyor under the laws of the state of Iowa

Signature: J.M. Hochstetler
Name typed or printed: J.M. Hochstetler

Date: 8/16/96 Reg. No. 6808

My registration renewal date is December 31, 1997

SEAL

PROFESSIONAL REGISTERED J.M. HOCHSTETLER 6808 IOWA LAND SURVEYOR

List Corners to be Indexed

Corners	Section	Twp	Range
W¼ Cor.	6	76	26
SW. Cor.	6	76	26