

COMPUTER   
RECORDED   
COMPARED

FILED NO. **1532**

BOOK 1 PAGE 431

REC \$ 5.00

96 DEC -3 AM 8:42

AUC \$ \_\_\_\_\_

MICHELLE UTSLER  
RECORDER  
MADISON COUNTY, IOWA

R.M.F. \$ 1.00

Prepared By: J. Brian Morrissey, Morrissey Surveying, 1926 Pammel Park Road, Winterset, Ia. 50273, Tele. (515) 462-2166

# UNITED STATES PUBLIC LAND SURVEY CORNER CERTIFICATE OF

Land Survey Monuments situated in Section 16, Township 75 N, Range 26 W, of the Fifth Principal Meridian, Madison County, Iowa.  
Previously recorded in \_\_\_\_\_ N.A. \_\_\_\_\_ in County Recorders Office.


(book, page, document number, etc.)

(Show reason for preparing this certificate, the evidence and detailed procedures used in establishing the corner positions and monumentation found or placed.)

Monument Description and Remarks: Set 5/8" capped rebar, #7995, at mathematical intersection of Quarter Quarter Section Corners. Quarter Section Corners, and fence corner at the NE. Corner of the NW. 1/4, NE. 1/4 were used where there were no Quarter Quarter Section Corners to determine position of said Quarter Quarter Corners.


## PLAN VIEW

(Show a minimum of three reference ties to durable physical objects, relevant monuments and physical conditions that will enable recovery of the corner.)

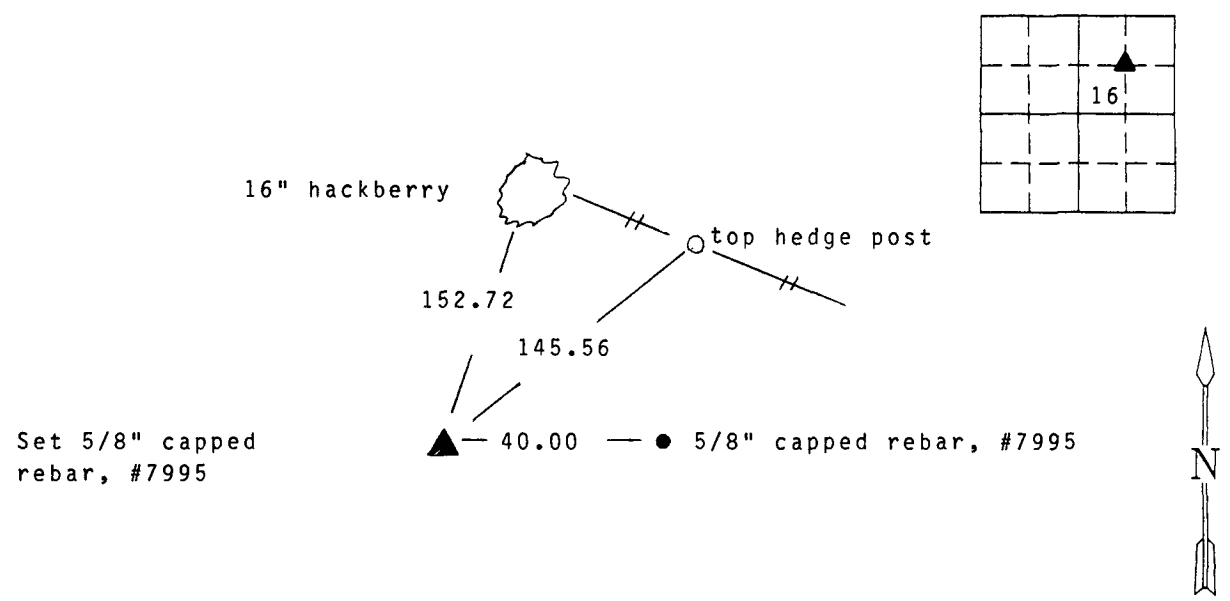

NE. Cor., SW. 1/4, NE. 1/4, Sec. 16

Note: all ties to "x" nails unless noted

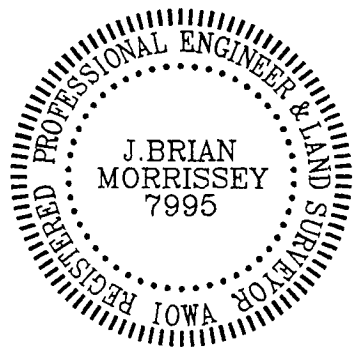

I hereby certify that the survey work was completed and this certificate was prepared by me or my direct personal supervision and that I am a duly registered land surveyor under the laws of the state of Iowa. My registration renewal date is 12/31/97.

Signature: J. Brian Morrissey

Name typed or printed: J. Brian Morrissey

Date: 12/2/96 Reg. No. 7995