COMPUTER ✓
RECORDED
COMPARED ✓

REC $5.00
AUD
R.M.F. $1.00

FILED NO. 1174
BOOK 1 PAGE 422
96 OCT 25 PM 2:36
MICHELLE UTSLER
RECORDER
MADISON COUNTY, IOWA

Prepared By: J. Brian Morrissey, Morrissey Surveying, 1926 Pammel Park Road, Winterset, Ia. 50273, Tele. (515) 462-2166

UNITED STATES PUBLIC LAND SURVEY CORNER CERTIFICATE OF

Land Survey Monuments situated in Section 30, Township 75 N, Range 28 W, of the Fifth Principal Meridian, Madison County, Iowa.
Previously recorded in N.A. in County Recorders Office.


(book,page,document number,etc.)


(Show reason for preparing this certificate, the evidence and detailed procedures used in establishing the corner positions and monumentation found or placed.)

Monument Description and Remarks: Set 5/8" capped rebar, #7995, at midpoint between NE. Cor. and calculated N. ¼ Cor., Sec. 30, based on centerline of county highway and fences to north along north side of Section.

PLAN VIEW

(Show a minimum of three reference ties to durable physical objects, relevant monuments and physical conditions that will enable recovery of the corner.)

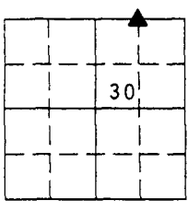

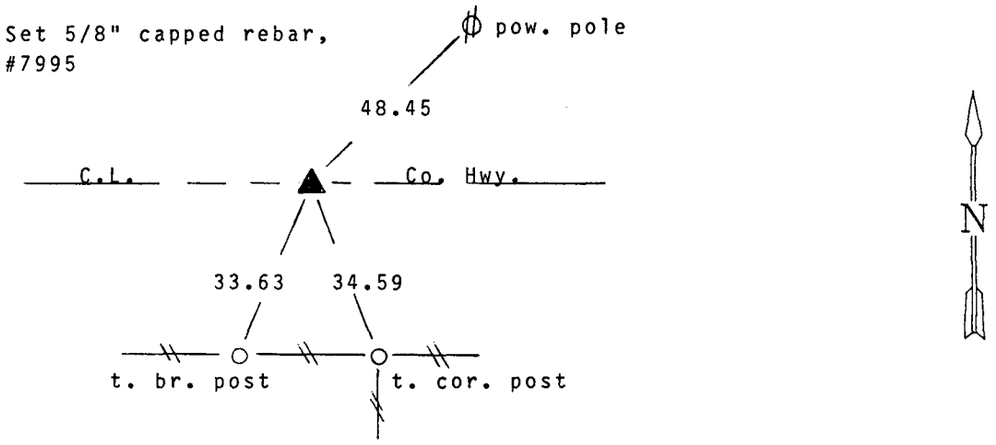

NW. Cor., NE. ¼, NE. ¼, Sec. 30.

Note: all ties to "x" nails unless noted

PROFESSIONAL ENGINEER & LAND SURVEYOR
J.BRIAN MORRISSEY
7995
IOWA

I hereby certify that the survey work was completed and this certificate was prepared by me or my direct personal supervision and that I am a duly registered land surveyor under the laws of the state of Iowa. My registration renewal date is 12/31/97.

Signature: J. Brian Morrissey

Name typed or printed: J. Brian Morrissey

Date: 10/9/96 Reg.No, 7995

153-96