COMPUTER ✓
✓
✓

REC $ 5.00
R.M.P. $ 1.00

FILED NO. 1873
BOOK 1 PAGE 450
97 JAN 13 AM 10: 28
MICHELLE UTSLER
RECORDER
MADISON COUNTY, IOWA

VANCE & HOCHSTETLER, P.C. CONSULTING ENGINEERS, WINTERSET, IOWA (515)462-399

CHARLES T. VANCE, 110 West Green St., Winterset, Iowa 50273
JAMES M. HOCHSTETLER, 110 West Green St., Winterset, Iowa 50273

SLSI 9-94

UNITED STATES PUBLIC LAND SURVEY CORNER CERTIFICATE

OF

Land Survey Monuments situated in Section 12, Township 74 North, Range 26 West, of the Fifth Principal Meridian, Madison County, Iowa.
Previously recorded in _____ (book, page, document number, etc.) in County Recorder's Office.

(Show reason for preparing this certificate, the evidence and detailed procedures used in establishing the corner positions and monumentation found or placed.)


Monument Description and Remarks:


NE cor. NW.1/4 NW.1/4 - Set CIR #6808 in fenceline at distance split between NW cor (fd. 3/4" square bolt) and N. 1/4 cor. (48" Cottonwood tree at 4-way fence corner).


PLAN - VIEW

(Show a minimum of three reference ties to durable physical objects, relevant monuments and physical conditions that will enable recovery of the corner.)

NE CORNER
NW.1/4 NW.1/4
SEC. 12-74-26
Set C.I.R. #6808

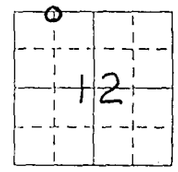

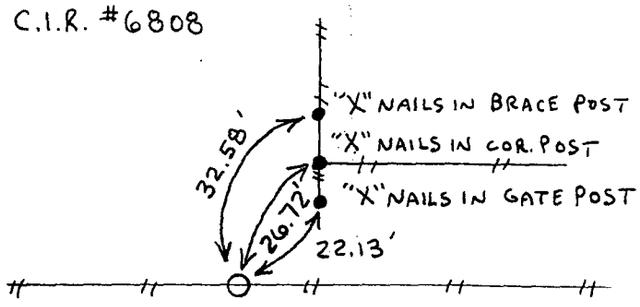

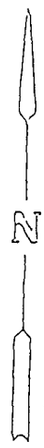

I hereby certify that this land surveying document was prepared and the related survey work was performed by me or under my direct personal supervision and that I am a duly licensed Land Surveyor under the laws of the State of Iowa.

J.M. HOCHSTETLER
License number 6808 Date 1/10/97
My license renewal date is December 31, 1997.
Pages or sheets covered by this seal: 1

LICENSED LAND SURVEYOR J.M. HOCHSTETLER 6808 IOWA

List Corners to be Indexed

Corners	Section	TWP	Range
NE cor. NW.1/4 NW.1/4	12	74N	26W