COMPUTER ✓
RECORDED ✓
COMPARED ✓

REC $ 5.00
AUD $
R.M.F. $ 1.00

FILED NO. 1546
BOOK 1 PAGE 445
96 DEC -3 AM 9:03
MICHELLE UTSLER
RECORDER
MADISON COUNTY, IOWA

Prepared By: J. Brian Morrissey, Morrissey Surveying, 1926 Pammel Park Road, Winterset, Ia. 50273, Tele. (515) 462-2166

UNITED STATES PUBLIC LAND SURVEY CORNER CERTIFICATE OF

Land Survey Monuments situated in Section 3, Township 75 N, Range 29 W, of the Fifth Principal Meridian, Madison County, Iowa.
Previously recorded in N.A. in County Recorders Office.


(book,page,document number,etc.)


(Show reason for preparing this certificate, the evidence and detailed procedures used in establishing the corner positions and monumentation found or placed.)

Monument Description and Remarks: Set 5/8" rebar, #7995, at midpoint between SW. Cor. Sec. 3 and fence corner at S. Quarter Corner. Verified position of fence corner by traversing S. line Sec. 3. Fence corner checked reasonably close to equal split of S. line of Sec. 3.

PLAN VIEW

(Show a minimum of three reference ties to durable physical objects, relevant monuments and physical conditions that will enable recovery of the corner.)

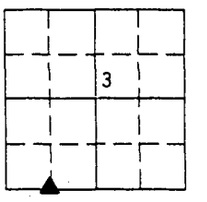

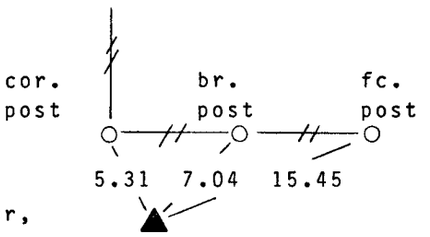

Set 5/8" capped rebar, #7995



SE. Cor., SW. ¼, SW. ¼, Sec. 3

Note: all ties to "x" nails

PROFESSIONAL ENGINEER & LAND SURVEYOR
J.BRIAN MORRISSEY 7995
IOWA REGISTERED

I hereby certify that the survey work was completed and this certificate was prepared by me or my direct personal supervision and that I am a duly registered land surveyor under the laws of the state of Iowa. My registration renewal date is 12/31/97.

Signature: J. Brian Morrissey

Name typed or printed: J. Brian Morrissey

Date: 11/26/96 Reg.No. 7995

168-96