

COMPUTER
RECORDED
RECORDED

FILED NO. 1875

BOOK 1 PAGE 452

REC 502

97 JAN 13 AM 10:32

AUD 100

R.M.F. \$ 1.00

MICHELLE UTSLER
RECORDER
MADISON COUNTY, IOWA

VANCE & HOCHSTETLER, P.C. CONSULTING ENGINEERS, WINTERSSET, IOWA (515) 462-399

CHARLES T. VANCE, 110 West Green St., Winterset, Iowa 50273

JAMES M. HOCHSTETLER, 110 West Green St., Winterset, Iowa 50273

SLS19-94

UNITED STATES PUBLIC LAND SURVEY CORNER CERTIFICATE

OF

Land Survey Monuments situated in Section 3, Township 77 N, Range 27 W, of the Fifth Principal Meridian, MADISON County, Iowa.
Previously recorded in _____ in County Recorder's Office.


(book, page, document number, etc.)

(Show reason for preparing this certificate, the evidence and detailed procedures used in establishing the corner positions and monumentation found or placed.)

Monument Description and Remarks: Southwest Corner Section 3, T77 N, R27 W -
Found Iron Pin 3" Below surface from ties in Madison County Engineers
records.

PLAN - VIEW

(Show a minimum of three reference ties to durable physical objects, relevant monuments and physical conditions that will enable recovery of the corner.)

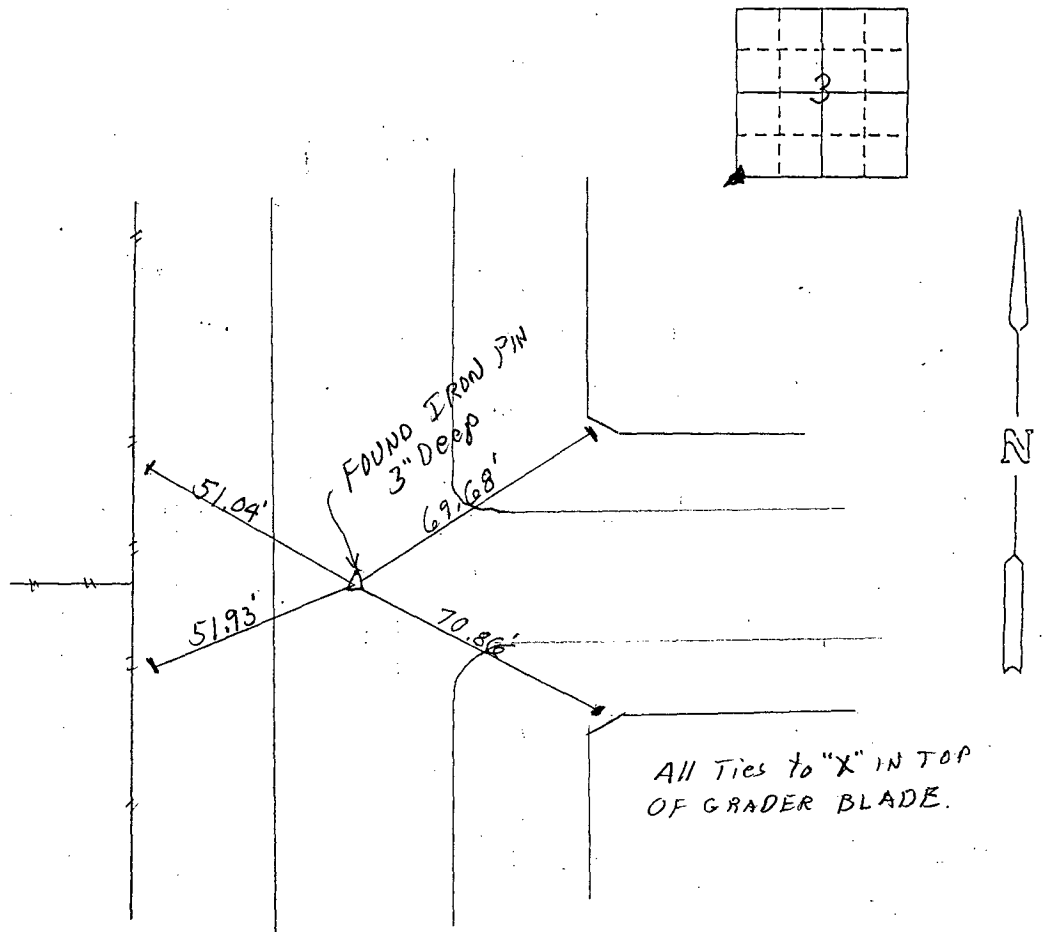

List Corners to be Indexed

Corners	Section	Twp	Range
SW COR.	3	77 N	27 W

I hereby certify that this land surveying document was prepared and the related survey work was performed by me or under my direct personal supervision and that I am a duly licensed Land Surveyor under the laws of the State of Iowa.

J. M. Hochstetler

J.M. HOCHSTETLER

License number 0008

Exp. 12/30/96
1997

My license renewal due is December 31, _____.

Pages or sheets covered by this set: _____

