

REC. # 500  
C.M.P. # 100

STATE OF IOWA  
MADISON COUNTY } SS

2155

Filed for record the 13 day of Feb.  
A. D. 19. 97. at 8:32 clock A.M.  
Recorded in book 1 on page 458  
Michelle Utsler  
Betty M. Niblo

COMPUTER   
RECORDED   
COMPARED

VANCE & HOCHSTETLER, P.C. CONSULTING ENGINEERS, WINTERSSET, IOWA (515) 462-399

CHARLES T. VANCE, 110 West Green St., Winterset, Iowa 50273  
JAMES M. HOCHSTETLER, 110 West Green St., Winterset, Iowa 50273

SLS19-94

UNITED STATES PUBLIC LAND SURVEY CORNER CERTIFICATE

OF

Land Survey Monuments situated in Section 18, Township 75 NORTH, Range 27 WEST, of the Fifth Principal Meridian, MADISON County, Iowa. Previously recorded in \_\_\_\_\_ in County Recorder's Office.


(Show reason for preparing this certificate, the evidence and detailed procedures used in establishing the corner positions and monumentation found or placed.)

Monument Description and Remarks:  
West 1/4 cor. - Fd. C.I.R. #7044  
NW cor SW. Fr. 1/4 NW. 1/4 - Set C.I.R. #6808 in fence line on line between NW corner & W. 1/4 corner.  
SE cor SW. Fr. 1/4 NW. 1/4 - Fd. C.I.R. #7044

PLAN - VIEW



(Show a minimum of three reference ties to durable physical objects, relevant monuments and physical conditions that will enable recovery of the corner.)

WEST 1/4 COR.  
SEC. 18-75-27  
Fd. C.I.R. #7044

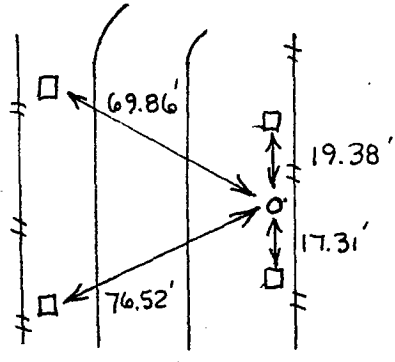


All ties are to "X"s cut in tops of Grader Blades

NW CORNER  
SW Frac. 1/4 NW. 1/4  
SEC. 18-75-27  
Set C.I.R. #6808

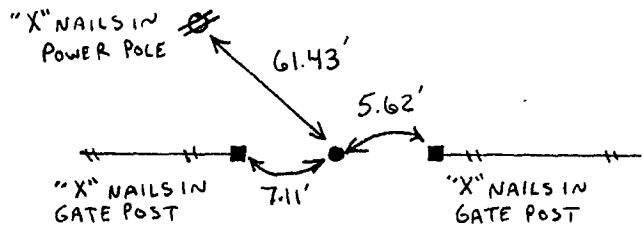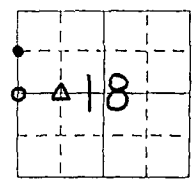

SE CORNER  
SW Frac. 1/4 NW. 1/4  
SEC. 18-75-27  
Fd. C.I.R. #7044

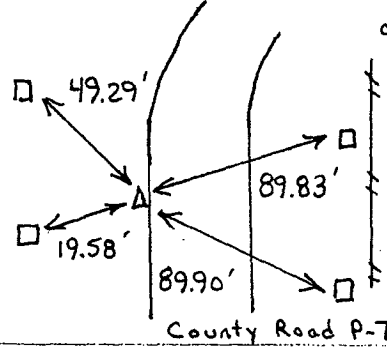

All ties are to "X"s cut in tops of Grader Blades



I hereby certify that this land surveying document was prepared and the related survey work was performed by me or under my direct personal supervision and that I am a duly licensed Land Surveyor under the laws of the State of Iowa.  
J. M. Hochstetler  
J.M. HOCHSTETLER  
License number 6808 Date 2/3/97  
My license renewal date is December 31, 1997.  
Pages or sheets covered by this seal: 1

List Corners to be Indexed

Corners	Section	Twp	Range
W. 1/4 cor.	18	75N	27W
NW cor. SW Frac. 1/4 NW. 1/4	18	75N	27W
SE cor. SW Frac. 1/4 NW. 1/4	18	75N	27W