COMPUTER ✓
RECORDED ✓
COMPARED ✓

REC $5.00
AUD $
R.M.F. $1.00

FILED NO. 2886
BOOK 1 PAGE 474
97 APR 21 PM 4:14
MICHELLE UTSLER
RECORDER
MADISON COUNTY, IOWA

Prepared By: J. Brian Morrissey, Morrissey Surveying, 1926 Pammel Park Road, Winterset, Ia. 50273, Tel. (515) 462-2166

UNITED STATES PUBLIC LAND SURVEY CORNER CERTIFICATE OF

Land Survey Monuments situated in Section 31, Township 75 N, Range 27 W, of the Fifth Principal Meridian, Madison County, Iowa.
Previously recorded in N.A. in County Recorders Office.


(book, page, document number, etc.)

(Show reason for preparing this certificate, the evidence and detailed procedures used in establishing the corner positions and monumentation found or placed.)

Monument Description and Remarks: FOUND 1" IRON PIN, PREVIOUSLY LOGGED BY COUNTY ENGINEERS OFFICE, ACCEPTED POSITION.

PLAN VIEW

(Show a minimum of three reference ties to durable physical objects, relevant monuments and physical conditions that will enable recovery of the corner.)

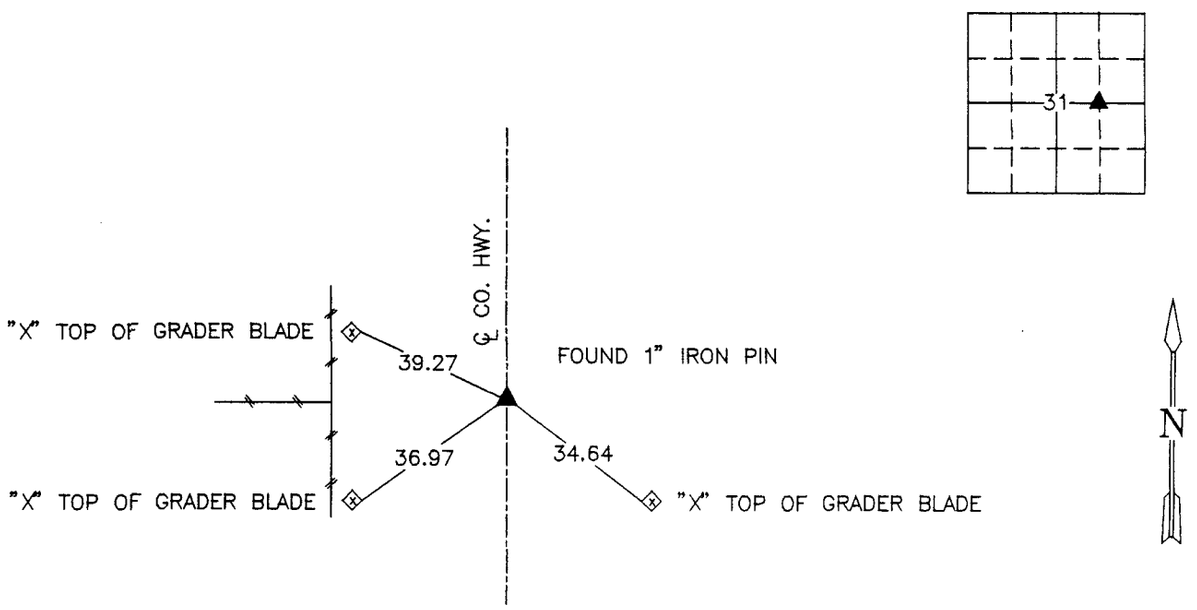

SE. COR., SW. 1/4, NE. 1/4 SEC. 31

NOTE: ALL TIES TO "X" NAILS UNLESS NOTED

PROFESSIONAL ENGINEER & LAND SURVEYOR
J.BRIAN MORRISSEY 7995
LICENSED IOWA

I hereby certify that the survey work was completed and this certificate was prepared by me or under my direct personal supervision and that I am a duly licensed Land Surveyor under the laws of the State of Iowa.

Signature: J. Brian Morrissey Date: 4/16/97
J. Brian Morrissey

License number 7995.
My license renewal date is December 31, 1997.

179-97