

COMPUTER  
RECORDED  
COMPARED

FILED NO. 3599

BOOK 1 PAGE 477

97 JUN 18 PM 2:34

MICHELLE UTSLER  
RECORDER  
MADISON COUNTY, IOWA

VANCE & HOCHSTETLER, P.C. CONSULTING ENGINEERS, WINTERSSET, IOWA (515) 462-399

CHARLES T. VANCE, 110 West Green St., Winterset, Iowa 50273

JAMES M. HOCHSTETLER, 110 West Green St., Winterset, Iowa 50273

SLSI 9-94

UNITED STATES PUBLIC LAND SURVEY CORNER CERTIFICATE

OF

Land Survey Monuments situated in Section 25, Township 75 North, Range 29 West, of the Fifth Principal Meridian, Madison County, Iowa.  
Previously recorded in \_\_\_\_\_ in County Recorder's Office.

(book, page, document number, etc.)

(Show reason for preparing this certificate, the evidence and detailed procedures used in establishing the corner positions and monumentation found or placed.)

Monument Description and Remarks:

SE cor. NW. 1/4 SE. 1/4 - Set C.I.R. #6808 at fence corner

NE cor. NW. 1/4 SE. 1/4 - Set C.I.R. #6808 at split of half mile fence

NE cor. SW. 1/4 NE. 1/4 - Set C.I.R. #6808 at fence corner

North 1/4 cor. - Set C.I.R. #6808 at centerline intersection

PLAN - VIEW


(Show a minimum of three reference ties to durable physical objects, relevant monuments and physical conditions that will enable recovery of the corner.)

SE CORNER

NW. 1/4 SE. 1/4

SEC. 25-75N-29W

Set C.I.R. #6808

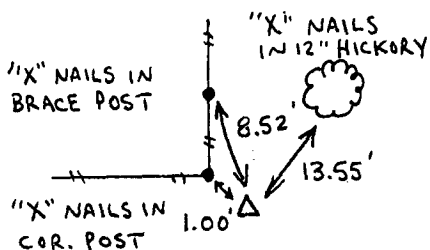


NE CORNER

SW. 1/4 NE. 1/4

SEC. 25-75N-29W

Set C.I.R. #6808

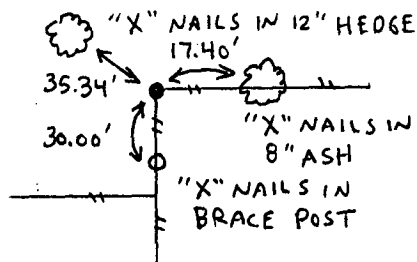


NE CORNER

NW. 1/4 SE. 1/4

SEC. 25-75N-29W


Set C.I.R. #6808

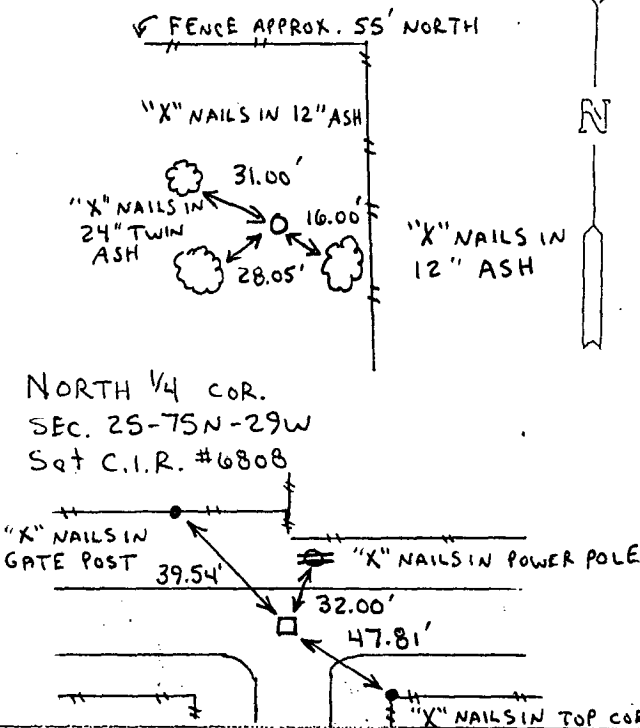

NORTH 1/4 cor.

SEC. 25-75N-29W

Set C.I.R. #6808

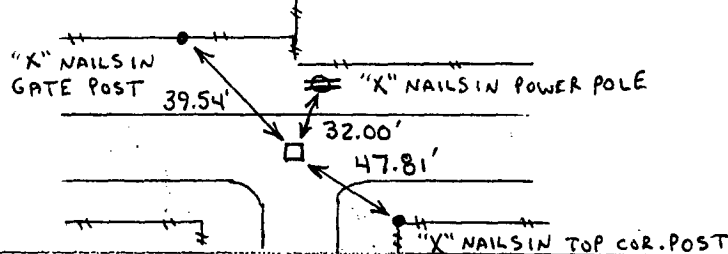

List Corners to be Indexed

| Corners         | Section | Twp  | Range |
|-----------------|---------|------|-------|
| SE cor          | 25      | 75 N | 29 W  |
| NW. 1/4 SE. 1/4 |         |      |       |
| NE cor.         | 25      | 75 N | 29 W  |
| NW. 1/4 SE. 1/4 |         |      |       |
| NE cor.         | 25      | 75 N | 29 W  |
| SW. 1/4 NE. 1/4 |         |      |       |
| N. 1/4 cor.     | 25      | 75 N | 29 W  |

I hereby certify that this land surveying document was prepared and the related survey work was performed by me or under my direct personal supervision and that I am a duly licensed Land Surveyor under the laws of the State of Iowa.

J. M. HOCHSTETLER

License number 6808

Date 6/2/97

My license renewal date is December 31, 1997.

Pages or sheets covered by this seal: 1

