


UNITED STATES PUBLIC LAND SURVEY CORNER CERTIFICATE

LAND SURVEY MONUMENT LOCATED IN SECTION 26, TOWNSHIP 76
NORTH, RANGE 27, OF THE 5TH P.M. MADISON COUNTY, IOWA
PREVIOUSLY RECORDED IN BOOK _____ ON PAGE _____

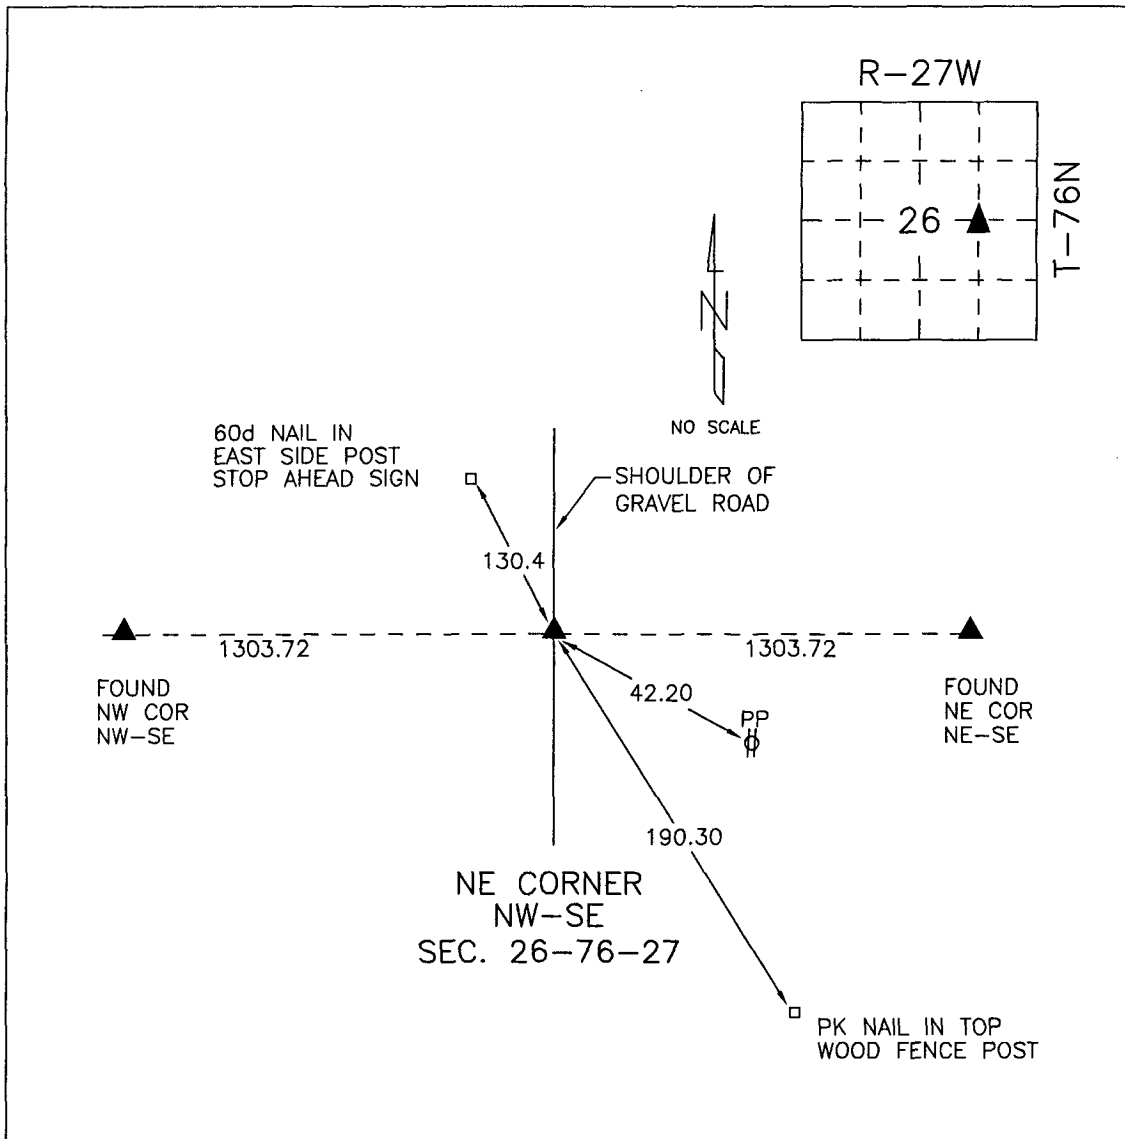

MONUMENT DESCRIPTION AND NARRATIVE NE COR. NW SE SEC. 26-76-27
SET 5/8" REBAR, WITH CAP #4129

I HEREBY CERTIFY THAT THIS PLAT AND SURVEY TIE WORK WAS COMPLETED BY ME OR UNDER MY DIRECT PERSONAL SUPERVISION AND THAT I AM A DULY REGISTERED LAND SURVEYOR UNDER THE LAWS OF THE STATE OF IOWA.

COMPUTER
RECORDED
COMPARED _____

REC \$ 5.00
AUD \$ _____
R.M.F. \$ 1.00

FILED NO. 556
BOOK 1 PAGE 501
97 AUG -7 AM 11:49

Jerry Shellberg
JERRY F. SHELLBERG IA. REG #4129 DATE AUGUST 5, 1997

MICHELLE UTSLEP
RECORDER
MADISON COUNTY IOWA