REC $ 5.00
AUD $
R.M.F. $ 1.00

COMPUTER ✓
RECORDED ✓
COMPARED ✓

FILED NO. 201
BOOK 1 PAGE 488
97 JUL 15 PM 3:42
MICHELLE UTSLER
RECORDER
MADISON COUNTY, IOWA

VANCE & HOCHSTETLER, P.C. CONSULTING ENGINEERS, WINTERSET, IOWA (515)462-3995
CHARLES T. VANCE, 110 West Green St., Winterset, Iowa 50273
JAMES M. HOCHSTETLER, 110 West Green St., Winterset, Iowa 50273

SLSI 9-94

UNITED STATES PUBLIC LAND SURVEY CORNER CERTIFICATE

OF

Land Survey Monuments situated in Section 12, Township 75 NORTH, Range 27 WEST, of the Fifth Principal Meridian, MADISON County, Iowa.
Previously recorded in _____ (book, page, document number, etc.) in County Recorder's Office.

(Show reason for preparing this certificate, the evidence and detailed procedures used in establishing the corner positions and monumentation found or placed.)


Monument Description and Remarks:

NE cor. - Set C.I.R. #6808 @ R.O.W. split in line with East-West fences.
SE cor. NE.1/4 NE.1/4 - Set C.I.R. #6808 @ split of E. line of NE.1/4
SW cor. NE.1/4 NE.1/4 - Set C.I.R. #6808 @ existing fence corner


PLAN - VIEW


(Show a minimum of three reference ties to durable physical objects, relevant monuments and physical conditions that will enable recovery of the corner.)

NE CORNER
SEC. 12-75N-27W
Set C.I.R. #6808

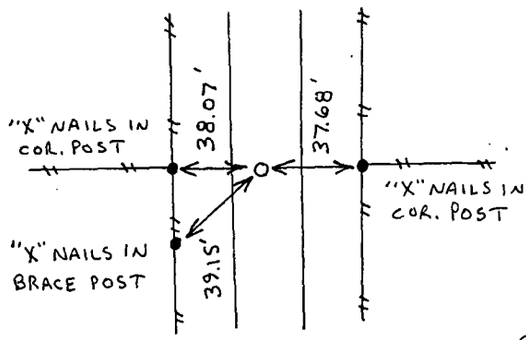


SE CORNER
NE.1/4 NE.1/4
SEC. 12-75-27
Set C.I.R. #6808

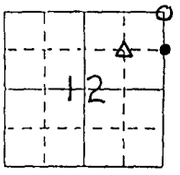

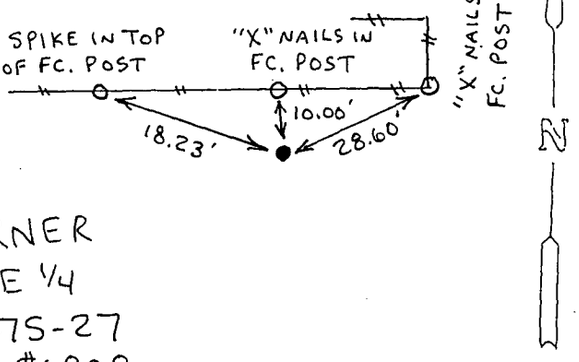

SW CORNER
NE 1/4 NE 1/4
SEC. 12-75-27
Set C.I.R. #6808

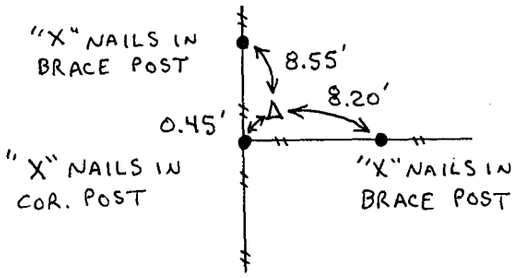

LICENSED LAND SURVEYOR
J.M. HOCHSTETLER
6808
IOWA

I hereby certify that this land surveying document was prepared and the related survey work was performed by me or under my direct personal supervision and that I am a duly licensed Land Surveyor under the laws of the State of Iowa.

J.M. Hochstetler

J.M. HOCHSTETLER
License number 6808 Date 7/10/97
My license renewal date is December 31, 1997.
Pages or sheets covered by this seal: 1

List Corners to be Indexed

Corners	Section	Twp	Range
NE cor.	12	75 N	27W
SE cor. NE.1/4 NE.1/4	12	75N	27W
SW cor. NE.1/4 NE.1/4	12	75N	27W