

COMPUTER
 RECORDED
 COMPARED

FILED NO. 284

BOOK 1 PAGE 489

97 JUL 21 PM 1:37

NICHELLE UTSLER
 RECORDER
 MADISON COUNTY, IOWA



Mer Engineering, Inc., 109 Regency West Court, Fort Dodge, Iowa Phone: 515-955-3635

UNITED STATES PUBLIC LAND SURVEY CORNER CERTIFICATE

Land Survey Monuments situated in Section 33, Township 75N, Range 29W, of the Fifth Principal Meridian, MADISON County, Iowa. Previously Recorded in _____ in County Recorder's Office. (book, page, document number, etc.)


(Show reason for preparing this certificate, the evidence and detailed procedures used in establishing the corner positions and monumentation found or placed.)

Monument Description and Remarks: CORNERS FOUND AS SHOWN. USED FOR BOUNDARY SURVEY IN NE 1/4 OF SAID SECTION 33.

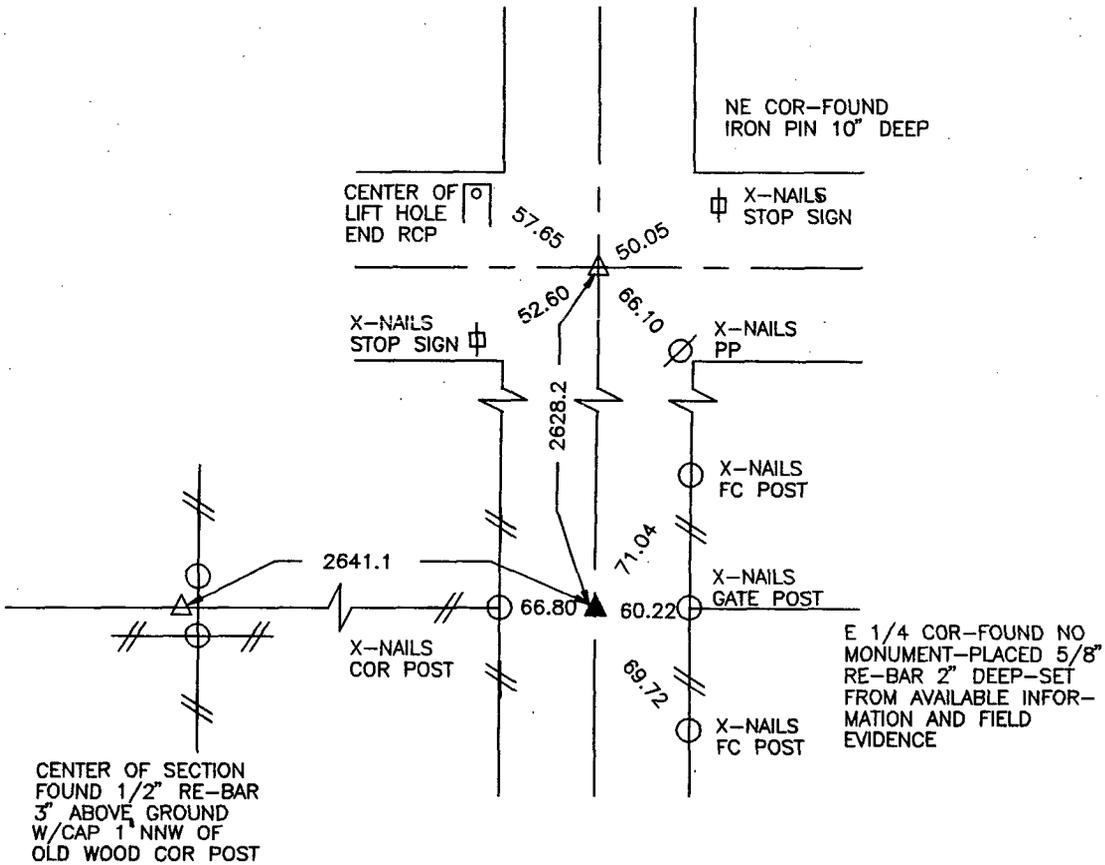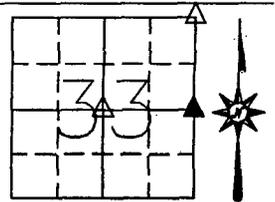

MER PROJECT # 6173

I HEREBY CERTIFY THAT THIS LAND SURVEYING DOCUMENT WAS PREPARED AND THE RELATED SURVEY WORK WAS PERFORMED BY ME OR UNDER MY DIRECT PERSONAL SUPERVISION AND THAT I AM A DULY LICENSED LAND SURVEYOR UNDER THE LAWS OF THE STATE OF IOWA.

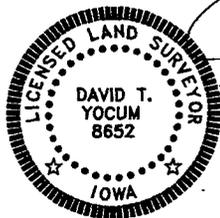

DAVID T. YOCUM

LICENSE NUMBER 8652

MY LICENSE RENEWAL DATE IS DECEMBER 31, 1997

List Corners to be Indexed

| Corners | Section | Twp | Range |
|-----------|---------|-----|-------|
| NE COR | 33 | 75N | 29W |
| E 1/4 COR | 33 | 75N | 29W |
| CENTER | 33 | 75N | 29W |

David Yocum 6/12/97
 (DATE)