

REC-506
AUD-
R.M.F. \$ 100

FILED NO. 1855
BOOK 1 PAGE 559
97 NOV 12 PM 3:21
MICHELLE UTSLER
RECORDER
MADISON COUNTY, IOWA

COMPUTER ✓
RECORDED ✓
COMPARED ✓

VANCE & HOCHSTETLER, P.C. CONSULTING ENGINEERS, WINTERSSET, IOWA (515) 462-3995

CHARLES T. VANCE, 110 West Green St., Winterset, Iowa 50273
JAMES M. HOCHSTETLER, 110 West Green St., Winterset, Iowa 50273
SLS19-94

UNITED STATES PUBLIC LAND SURVEY CORNER CERTIFICATE

OF
Land Survey Monuments situated in Section 25, Township 76 North, Range
26 West, of the Fifth Principal Meridian, MADISON County, Iowa.
Previously recorded in _____ in County Recorder's Office.
(book, page, document number, etc.)

(Show reason for preparing this certificate, the evidence and detailed procedures used in establishing the corner positions and monumentation found or placed.)




Monument Description and Remarks:

NE cor. SE. $\frac{1}{4}$ NE. $\frac{1}{4}$ - Set C.I.R. #6808 on the East line of the
NE. $\frac{1}{4}$ of Sec. 30 in line with an existing fence line extending
east.

PLAN - VIEW

(Show a minimum of three reference ties to durable physical objects, relevant monuments and physical conditions that will enable recovery of the corner.)

NE CORNER
SE. $\frac{1}{4}$ NE. $\frac{1}{4}$
SEC. 25-76-26
Set C.I.R. #6808

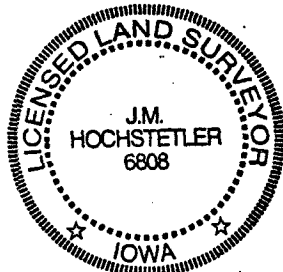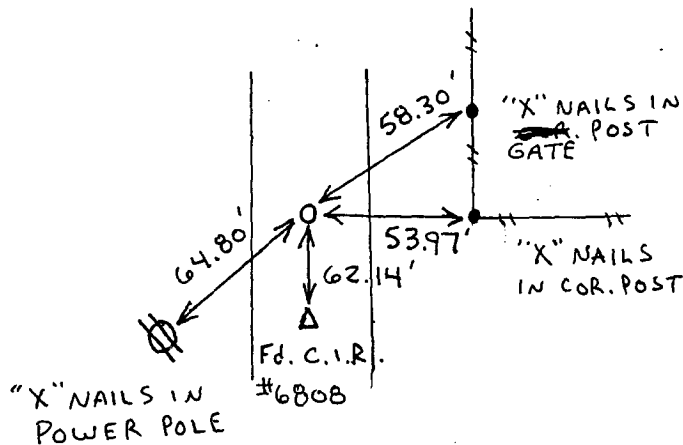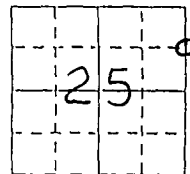

I hereby certify that this land surveying document was prepared and the related survey work was performed by me or under my direct personal supervision and that I am a duly licensed Land Surveyor under the laws of the State of Iowa.

J. M. Hochstetler
J.M. HOCHSTETLER

License number 6808

My license renewal date is December 31, 1997.

Pages or sheets covered by this seal: 1

List Corners to be Indexed

Corners	Section	Twp	Range
NE cor.	25	76 N	26 W
SE. $\frac{1}{4}$ NE. $\frac{1}{4}$			