97-182

REC $ 5.00
AUD $
R.M.F. $ 1.00
COMPUTER ✓
RECORDED ✓
COMPARED ✓

FILED NO. 2510
BOOK 1 PAGE 569
98 JAN -7 PM 1:25
MICHELLE UTSLER
RECORDER
MADISON COUNTY, IOWA

VANCE & HOCHSTETLER, P.C. CONSULTING ENGINEERS, WINTERSET, IOWA (515)462-3995
CHARLES T. VANCE, 110 West Green St., Winterset, Iowa 50273
JAMES M. HOCHSTETLER, 110 West Green St., Winterset, Iowa 50273

SLSI 9-94

UNITED STATES PUBLIC LAND SURVEY CORNER CERTIFICATE

OF

Land Survey Monuments situated in Section 25, Township 76 N, Range 26 W, of the Fifth Principal Meridian, MADISON County, Iowa.
Previously recorded in _____ (book, page, document number, etc.) in County Recorder's Office.


(Show reason for preparing this certificate, the evidence and detailed procedures used in establishing the corner positions and monumentation found or placed.)


Monument Description and Remarks: CENTER - Found ~~5/8~~ "I.R. at Fe. Corner - Used by DOT for Hwy "92 ROW
SW Cor SE¼ NW¼ - SET CIR # 6808 at old existing fence corner
NE Cor NW¼ SE¼ - Found I.DOT CIR. Set on line between Center and E¼ Corner.

PLAN - VIEW


(Show a minimum of three reference ties to durable physical objects, relevant monuments and physical conditions that will enable recovery of the corner.)

CENTER - SECTION 25-76-26

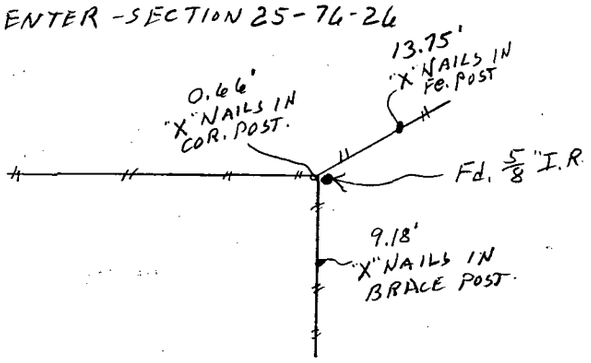


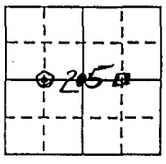

NE. COR NW¼ SE¼
SECTION 25-76-26

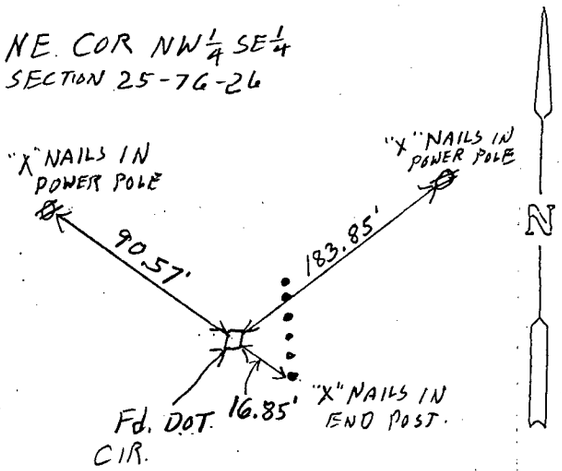

SW COR SE¼ NW¼
SECTION 25-76-26

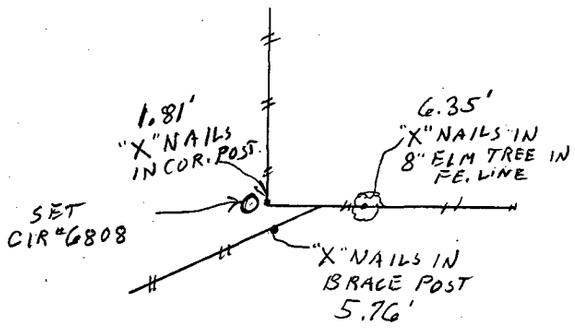

I hereby certify that this land surveying document was prepared and the related survey work was performed by me or under my direct personal supervision and that I am a duly licensed Land Surveyor under the laws of the State of Iowa.

J.M. HOCHSTETLER
License number 6808
Date 12/31/97
My license renewal date is December 31, 1997.
Pages or sheets covered by this seal: 1

LICENSED LAND SURVEYOR J.M. HOCHSTETLER 6808 IOWA

List Corners to be Indexed

Corners	Section	Twp	Range
CENTER	25	76	26
SW COR. SE¼ NW¼	25	76	26
NE COR NW¼ SE¼	25	76	26