

REC \$ 5.00
AUD \$
R.M.F. \$ 1.00

FILED NO: 3894
BOOK 1 PAGE 611
98 APR -9 PM 2: 02
MICHELLE UTSLER
RECORDER
MADISON COUNTY, IOWA

VANCE & HOCHSTETLER, P.C. CONSULTING ENGINEERS, WINTERSET, IOWA (515)462-3995

CHARLES T. VANCE, 110 West Green St., Winterset, Iowa 50273
JAMES M. HOCHSTETLER, 110 West Green St., Winterset, Iowa 50273

SLS19-94

UNITED STATES PUBLIC LAND SURVEY CORNER CERTIFICATE

OF

Land Survey Monuments situated in Section 24, Township 75 N, Range 26 W, of the Fifth Principal Meridian, MADISON County, Iowa.
Previously recorded in _____ in County Recorder's Office.


(book, page, document number, etc.)

(Show reason for preparing this certificate, the evidence and detailed procedures used in establishing the corner positions and monumentation found or placed.)

Monument Description and Remarks: NE COR. SE 1/4 NE 1/4 SEC. 24 T75N R26W - Set CIR by projecting the N. line of the SW 1/4 of the NE 1/4 of Section 24, T75N R26W of the 5th PM. Madison County to intersect a straight line between the certified corners at the NW & W 1/4 of Section 19, T75N, R25W of the 5th PM Warren Co.

PLAN - VIEW

(Show a minimum of three reference ties to durable physical objects, relevant monuments and physical conditions that will enable recovery of the corner.)

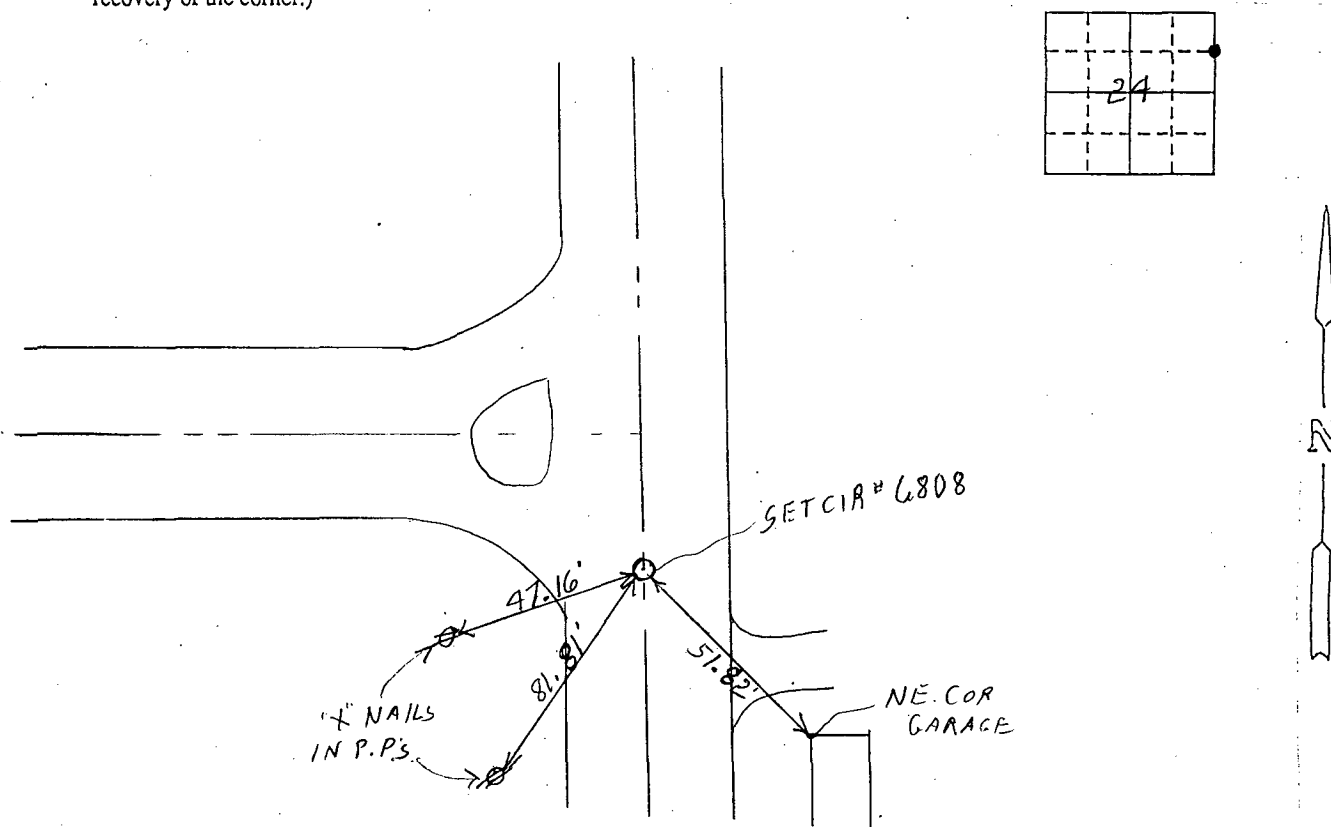

List Corners to be Indexed

Corners	Section	Twp	Range
NE COR SE 1/4 NE 1/4	24	75N	26W

I hereby certify that this land surveying document was prepared and the related survey work was performed by me or under my direct personal supervision and that I am a duly licensed Land Surveyor under the laws of the State of Iowa.

J.M. Hochstetler
J.M. HOCHSTETLER

License number 6808

Date 3/27/98

My license renewal date is December 31, 1999.

Pages or sheets covered by this seal: 1

