

REC \$ 5<sup>00</sup>  
AUD \$ \_\_\_\_\_  
R.M.F. \$ 1<sup>00</sup>

COMPUTER   
RECORDED   
COMPARED

FILED NO. 3981  
BOOK 1 PAGE 616  
98 APR 15 PM 1:31

Prepared By: J. Brian Morrissey, Morrissey Surveying, 1926 Pammel Park Road, Winterset, Ia. 50273, Telephone (515) 462-2166  
MICHELLE UTSLET  
RECORDED  
MADISON COUNTY, IOWA

# UNITED STATES PUBLIC LAND SURVEY CORNER CERTIFICATE OF



Land Survey Monuments situated in Section 13 and 18, Township 74 N, Range 30 W and 29 W, of the Fifth Principal Meridian, Adair and Madison County, Iowa.  
Previously recorded in N. A. in County Recorders Office.  
(book, page, document number, etc.)

(Show reason for preparing this certificate, the evidence and detailed procedures used in establishing the corner positions and monumentation found or placed.)

Monument Description and Remarks: Set P-K nail at intersection of centerline of highway and fence north and south based on Adair County and Madison County highway plans and right of way easements.

## PLAN VIEW

(Show a minimum of three reference ties to durable physical objects, relevant monuments and physical conditions that will enable recovery of the corner.)

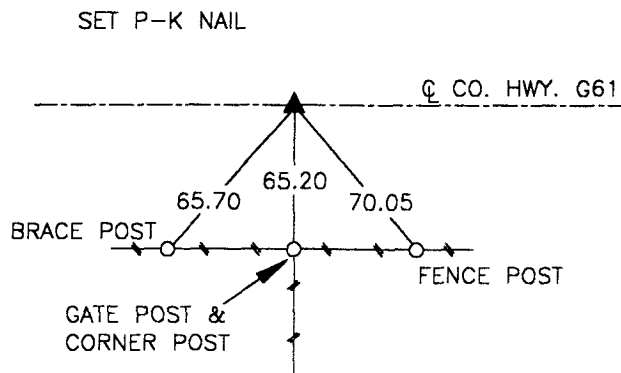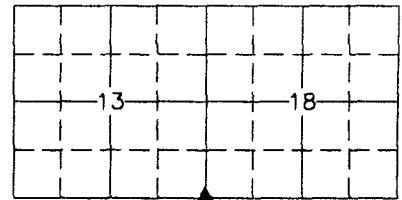

SE. COR., SEC. 13

SW. COR., SEC. 18

NOTE: ALL TIES TO "X" NAILS UNLESS NOTED



I hereby certify that the survey work was completed and this certificate was prepared by me or under my direct personal supervision and that I am a duly Licensed Land Surveyor under the laws of the State of Iowa.

Signature: J. Brian Morrissey Date: 4/14/98  
J. Brian Morrissey

License number 7995.

My license renewal date is December 31, 1999.

237-98-1