93-395

REC $ 5.00
AUD $
R.M.F. $ 1.00

COMPUTER ✓
RECORDED ✓
COMPARED ✓

FILED NO. 4113
BOOK 1 PAGE 617
98 APR 23 PM 2:03
MICHELLE UTSLER
RECORDER
MADISON COUNTY, IOWA

VANCE & HOCHSTETLER,P.C. CONSULTING ENGINEERS, WINTERSET, IOWA (515)462-3995
CHARLES T. VANCE, 110 West Green St., Winterset, Iowa 50273
JAMES M. HOCHSTETLER, 110 West Green St., Winterset, Iowa 50273

SLSI 9-94

# UNITED STATES PUBLIC LAND SURVEY CORNER CERTIFICATE

OF


Land Survey Monuments situated in Section 28, Township 76 N, Range 27 W, of the Fifth Principal Meridian, MADISON County, Iowa.
Previously recorded in _____ in County Recorder's Office.
(book, page, document number, etc.)

(Show reason for preparing this certificate, the evidence and detailed procedures used in establishing the corner positions and monumentation found or placed.)

Monument Description and Remarks: Center of Section - Found Limestone referenced in ties filed with Co. Engineer 4/19/87. Ties indicated a 5/8" Iron Pin set flush with surface which we could not find. The old ties were still intact. SET CIR #6808 by Stone

## PLAN - VIEW

(Show a minimum of three reference ties to durable physical objects, relevant monuments and physical conditions that will enable recovery of the corner.)

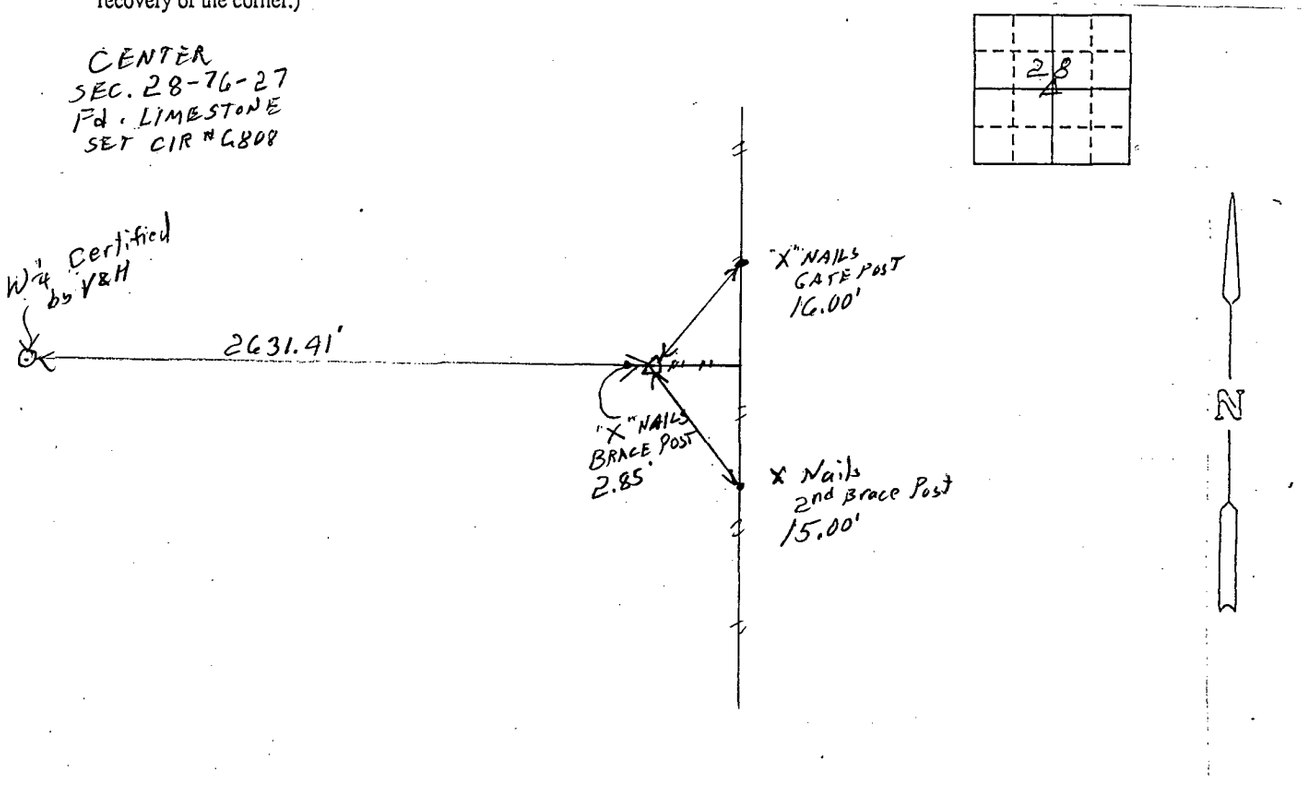


I hereby certify that this land surveying document was prepared and the related survey work was performed by me or under my direct personal supervision and that I am a duly licensed Land Surveyor under the laws of the State of Iowa.

J.M. HOCHSTETLER
License number 6808 Date 3/23/98
My license renewal date is December 31, 1999.
Pages or sheets covered by this seal: 1

LICENSED LAND SURVEYOR J.M. HOCHSTETLER 6808 IOWA

List Corners to be Indexed

| Corners | Section | Twp | Range |
|---|---|---|---|
| CENTER | 28 | 76N | 27W |