4540

COMPARED
RECORDED
COMPUTER

FILED NO. _____
BOOK 1 PAGE 621
98 MAY 15 PM 3:40
MICHELLE UTSLER
RECORDER
MADISON COUNTY, IOWA

REC $ 5.00
AUD $ _____
R.M.F. $ 5.00

VANCE & HOCHSTETLER, P.C., CONSULTING ENGINEERS, WINTERSET, IOWA (515) 462-3995
CHARLES T. VANCE, 110 West Green St., Winterset, Iowa, 50273
JAMES M HOCHSTETLER, 110 West Green St., Winterset, Iowa 50273

# UNITED STATES PUBLIC LAND SURVEY CORNER CERTIFICATE

OF

Land Survey Monuments situated in Section 36, Township 75 North, Range 26 West, of the Fifth Principal Meridian, Madison County, Iowa.
Previously recorded in _____ in County Recorder's Office.
(book, page, document number, etc.)

(Show reason for preparing this certificate, the evidence and detailed procedures used in establishing the the corner positions and monumentation found or placed.)

Monument Description and Remarks:


W. 1/4 cor. - Set C.I.R. #6808 at existing fence corner


SE cor. SW.1/4 SW.1/4 - Set C.I.R. #6808 at ℄-℄ intersection

## PLAN - VIEW


(Show a minimum of three reference ties to durable physical objects, relevant monuments and physical conditions that will enable recovery of the corner.)

WEST 1/4 COR.
SEC. 36-75-26
Set C.I.R. #6808

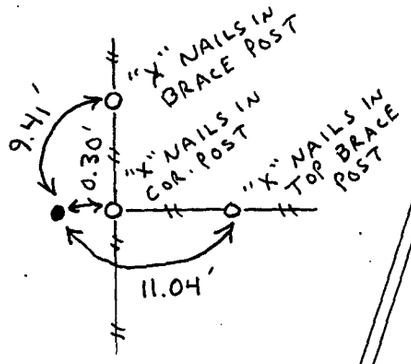

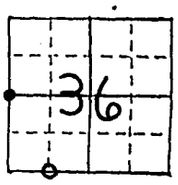
SE CORNER
SW. 1/4 SW. 1/4
SEC. 36-75-26
Set C.I.R. #6808



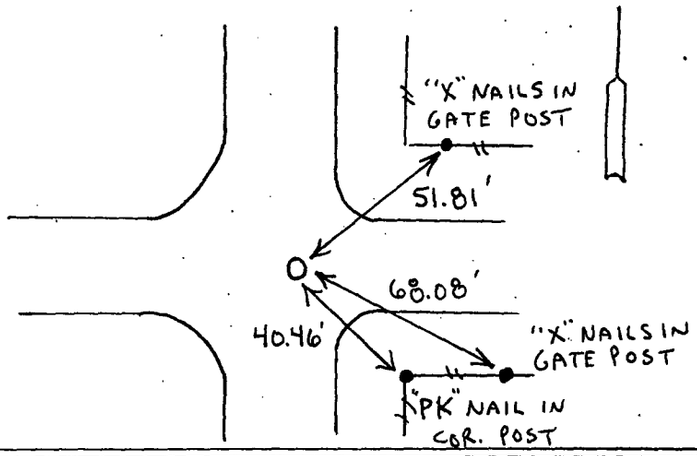



I hereby certify that this land surveying document was prepared and the related survey work was performed by me or under my direct personal supervision and that I am a duly licensed Land Surveyor under the laws of the State of Iowa.

J.M. HOCHSTETLER
License number 6808 Date 5/14/98
My license renewal date is December 31, 1999.
Pages or sheets covered by this seal: 1

List Corners to be Indexed

| Corners | Section | Twp | Range |
|---|---|---|---|
| W. 1/4 cor. | 36 | 75N | 26W |
| SE cor. SW.1/4 SW.1/4 | 36 | 75N | 26W |