FILED NO. 241

BOOK 1 PAGE 679

98 JUL 14 PM 12: 27

MICHELLE UTSLER
RECORDER
MADISON COUNTY, IOWA

REC $ No fee

AUD $

R.M.F. $

COMPUTER ✓

RECORDED ✓

COMPARED ✓

Prepared By: J. Brian Morrissey, Madison County Engineer, P.O. Box 152 Winterset, Ia. 50273, Tel. 462-3106

UNITED STATES PUBLIC LAND SURVEY CORNER CERTIFICATE OF

Land Survey Monuments situated in Section 7, Township 77 N, Range 28 W, of the Fifth Principal Meridian, Madison County, Iowa.
Previously recorded in N.A. in County Recorders Office.


(book, page, document number, etc.)


(Show reason for preparing this certificate, the evidence and detailed procedures used in establishing the corner positions and monumentation found or placed.)

Monument Description and Remarks: Set 5/8" capped rebar, #7995, at midpoint between SE. corner and South 1/4 corner. South 1/4 corner position based on traversing section using found section corners.

PLAN VIEW

(Show a minimum of three reference ties to durable physical objects, relevant monuments and physical conditions that will enable recovery of the corner.)

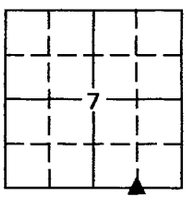

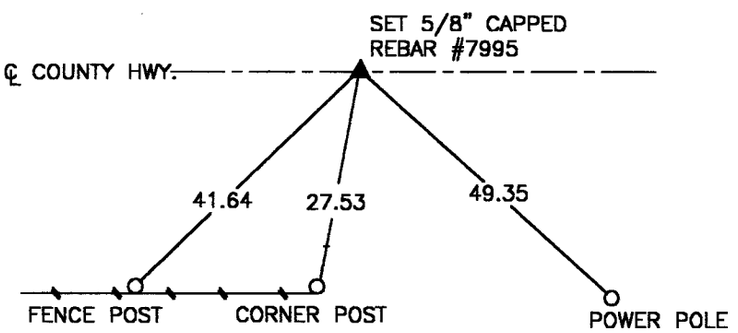



SE. COR., SW. 1/4, SE. 1/4, SEC. 7

NOTE: ALL TIES TO "X" NAILS UNLESS NOTED



I hereby certify that the survey work was completed and this certificate was prepared by me or under my direct personal supervision and that I am a duly Licensed Land Surveyor under the laws of the State of Iowa.

Signature: J. Brian Morrissey Date: 7/7/98

J. Brian Morrissey

License number 7995.

My license renewal date is December 31, 1999.