COMPUTER ✓
RECORDED ✓
COMPARED

FILED NO. 992
BOOK 1 PAGE 695
98 AUG 27 PM 2:27
MICHELLE UTSLER
RECORDER
MADISON COUNTY, IOWA

REC $ 5.00
AUD $
R.M.F. $ 1.00

VANCE & HOCHSTETLER, P.C., CONSULTING ENGINEERS, WINTERSET, IOWA (515) 462-3995
CHARLES T. VANCE, 110 West Green St., Winterset, Iowa, 50273
JAMES M HOCHSTETLER, 110 West Green St., Winterset, Iowa 50273

UNITED STATES PUBLIC LAND SURVEY CORNER CERTIFICATE
OF

Land Survey Monuments situated in Section 9, Township 76 NORTH, Range 26 WEST, of the Fifth Principal Meridian, MADISON County, Iowa.
Previously recorded in _____ in County Recorder's Office.
(book, page, document number, etc.)


(Show reason for preparing this certificate, the evidence and detailed procedures used in establishing the the corner positions and monumentation found or placed.)
Monument Description and Remarks:

SW COR. NW 1/4 SE 1/4 - SET C.I.R. #6808 AT CALCULATED CORNER


SE COR. NW 1/4 SE 1/4 - SET C.I.R. #6808 AT CALCULATED CORNER

PLAN - VIEW


(Show a minimum of three reference ties to durable physical objects, relevant monuments and physical conditions that will enable recovery of the corner.)

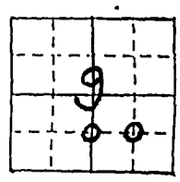


SW CORNER
NW 1/4 SE 1/4
SEC. 9-76-26
SET C.I.R. #6808

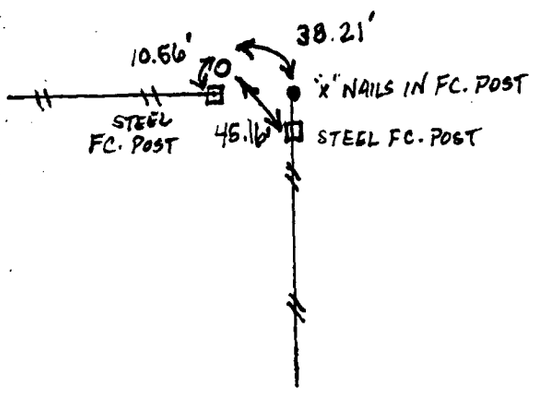

SE CORNER
NW 1/4 SE 1/4
SEC. 9-76-26
SET C.I.R. #6808

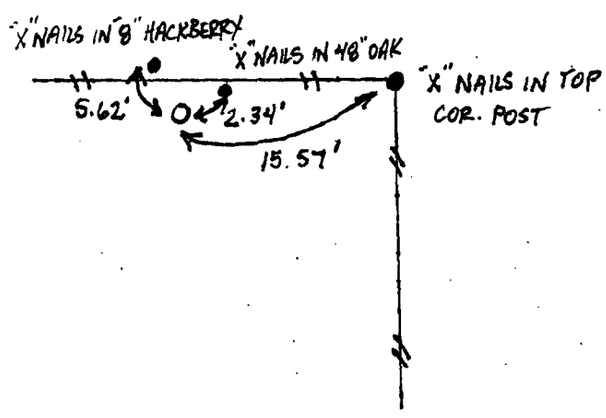

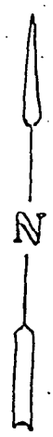

LICENSED LAND SURVEYOR
J.M. HOCHSTETLER
6808
IOWA

I hereby certify that this land surveying document was prepared and the related survey work was performed by me or under my direct personal supervision and that I am a duly licensed Land Surveyor under the laws of the State of Iowa.

J.M. HOCHSTETLER
License number 6808
Date 8/11/98
My license renewal date is December 31, 1999
Pages or sheets covered by this seal: 1

List Corners to be Indexed

Corners	Section	Twp	Range
S.W. COR. NW 1/4 SE 1/4	9	76N	26W
SE COR. NW 1/4 SE 1/4	9	76N	26W