COMPUTER ✓
RECORDED ✓
COMPARED ✓

REC $ 5.00
AUD $
R.M.F. $ 1.00

FILED NO. 1096
BOOK 1 PAGE 697
98 SEP -2 PM 2:10
MICHELLE UTSLER
RECORDER
MADISON COUNTY, IOWA

Prepared By: J. Brian Morrissey, Morrissey Surveying, 1926 Pammel Park Road, Winterset, Ia. 50273, Tel. (515) 462-2166

UNITED STATES PUBLIC LAND SURVEY CORNER CERTIFICATE OF

Land Survey Monuments situated in Section 17, Township 75 N, Range 27 W, of the Fifth Principal Meridian, Madison County, Iowa.
Previously recorded in N.A. in County Recorders Office.


(book, page, document number, etc.)

(Show reason for preparing this certificate, the evidence and detailed procedures used in establishing the corner positions and monumentation found or placed.)

Monument Description and Remarks: Found nail over 5/8" iron pin, 6" deep, accepted position of iron pin.

PLAN VIEW

(Show a minimum of three reference ties to durable physical objects, relevant monuments and physical conditions that will enable recovery of the corner.)

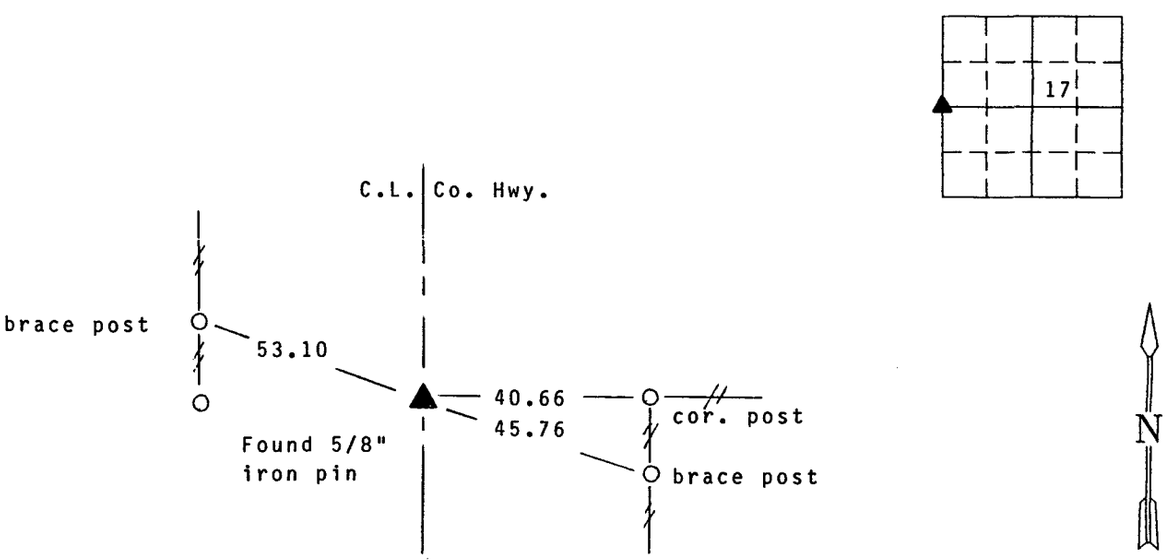

NW. Corner, SW. ¼, Sec. 17

Note: all ties to "x" nails

PROFESSIONAL ENGINEER & LAND SURVEYOR
J. BRIAN MORRISSEY
7995
IOWA

I hereby certify that this land surveying document was prepared and the related survey work was performed by me or under my direct personal supervision and that I am a duly licensed Land Surveyor under the laws of the State of Iowa.

Signature: J. Brian Morrissey Date: 9/1/98
J. Brian Morrissey

License number 7995.
My license renewal date is December 31, 1999.

258-98