



IOWA DEPARTMENT OF TRANSPORTATION
HIGHWAY DIVISION

Agreement for Revision of Access

Parcel No. 18
County Madison
Project FN-169-3(10)--21-61
Highway Number U.S. 169

THIS AGREEMENT, made and entered into by and between Clarence E. Johnson

the present owner of land adjacent to the above referenced highway, (hereafter referred to as the Owners), and the Iowa Department of Transportation, acting for the State of Iowa, (hereafter referred to as the Department);

1. IDENTIFICATION

The Owners own land generally located in 1/4 1/4 Sec. (or lot) _____ of Sec. (or Blk.) _____ and parts of 1/4 1/4 Sec. (or lot) _____

of Sec. ~~(or Blk.)~~ 35 in Twp. 76N, Rge. 28W, or (Sub. Div.) _____ (in the City of)

_____, County of Madison, State of Iowa; more particularly to which the State of Iowa has acquired

access rights by ~~deed~~ (or condemnation) from Will C. Johnson and Clarence E. Johnson

Recorded 10-14-74

recorded in Book (Vol.) 111, Page 89 (Instrument No.) _____ in the office of the Madison County Recorder.

2. REQUESTED ACCESS REVISION

The said Owners now desire to change the location of the Type "C" entrance (right of access) reserved at Sta.

667+00 east side, to a Type "C" entrance (right of access) at Sta. 663+00 east side, substituting the latter for the former;

PLAT OF ENTRANCE AS PROPOSED TO BE CONSTRUCTED IS ATTACHED TO AND IS A PART OF THIS APPLICATION. (Form 640002)

3. AGREEMENT

The Department and the Owners agree that the said entrance (right of access) desired by said Owners specified above is substituted for the entrance (right of access) formerly reserved, and in lieu thereof. In all other respects said deed (or condemnation) remains as before, and the rights acquired thereby, with these changes only, remain in the State of Iowa, as against the said Owners, their heirs, assigns, and successors in interest.

(Words and phrases herein, including acknowledgement hereof, shall be construed as in the singular or plural, and as masculine, feminine or neuter gender according to the context.)

Reviewed and Recommended for Approval by:

9/15/87 Thomas Donahy
Date Resident Maintenance Engineer

9/18/87 Donald R. Skene
Date Authorized District Agent

Date _____ Authorized City or Town Official

9/10/87 Jerry K. Trevillian
Date Authorized County Zoning Official

Revision of Access hereby requested is approved and granted by the Department of Transportation, Highway Division by

Seland D. Amstutz
Director, Operations Bureau or Authorized Agent
Iowa Department of Transportation
by Lorey Meinte

on October 14, 1987

FILED NO. 7020
BOOK 38 PAGE 74

1987 OCT 20 AM 10:09

MARY E. WELTY
RECORDER
MADISON COUNTY, IOWA
Fee \$10.00

OWNERS

Signed on this 9th day of September, 1987

(Type or Block Print Names below signature)

Clarence E. Johnson

CLARENCE E. JOHNSON

OWNERS ACKNOWLEDGEMENT

STATE OF IOWA: ss

On this 9 day of Sept, 1987, before me, the undersigned, a Notary Public, in and for the State of

Iowa, personally appeared, Clarence E. Johnson

to me known to be the identical persons named in and who executed the foregoing instrument and acknowledged that they executed the same as their voluntary act and deed.

Jerry C. Estell
Notary Public in and for the

Iowa
State of Iowa

(See Page 2 for additional Owner Acknowledgement. If none state none

none)

Form 640002
1-78

IOWA DEPARTMENT OF TRANSPORTATION
Highway Division


ACCESS PLAT

No. _____
County MADISON
Proj. No. FN-169-3(6)-2-61

SPECIAL PUBLIC ROAD CONNECTION
Access Rights Acquired Attach to Form 640001 635-055
CHECK XXX

PRIVATE PROPERTY ENTRANCE
Access Rights Not Acquired Attach to Form 640004

Location Descriptor: Primary Road No. U.S. 169, Sec. 35, T. 76N., R. 28W., MADISON County,
Being .53 Miles North From SOUTH junction of U.S. 169 and Iowa 92
direction
Being More Specifically described as: JAMES M. MOORE AND MYRNA MOORE

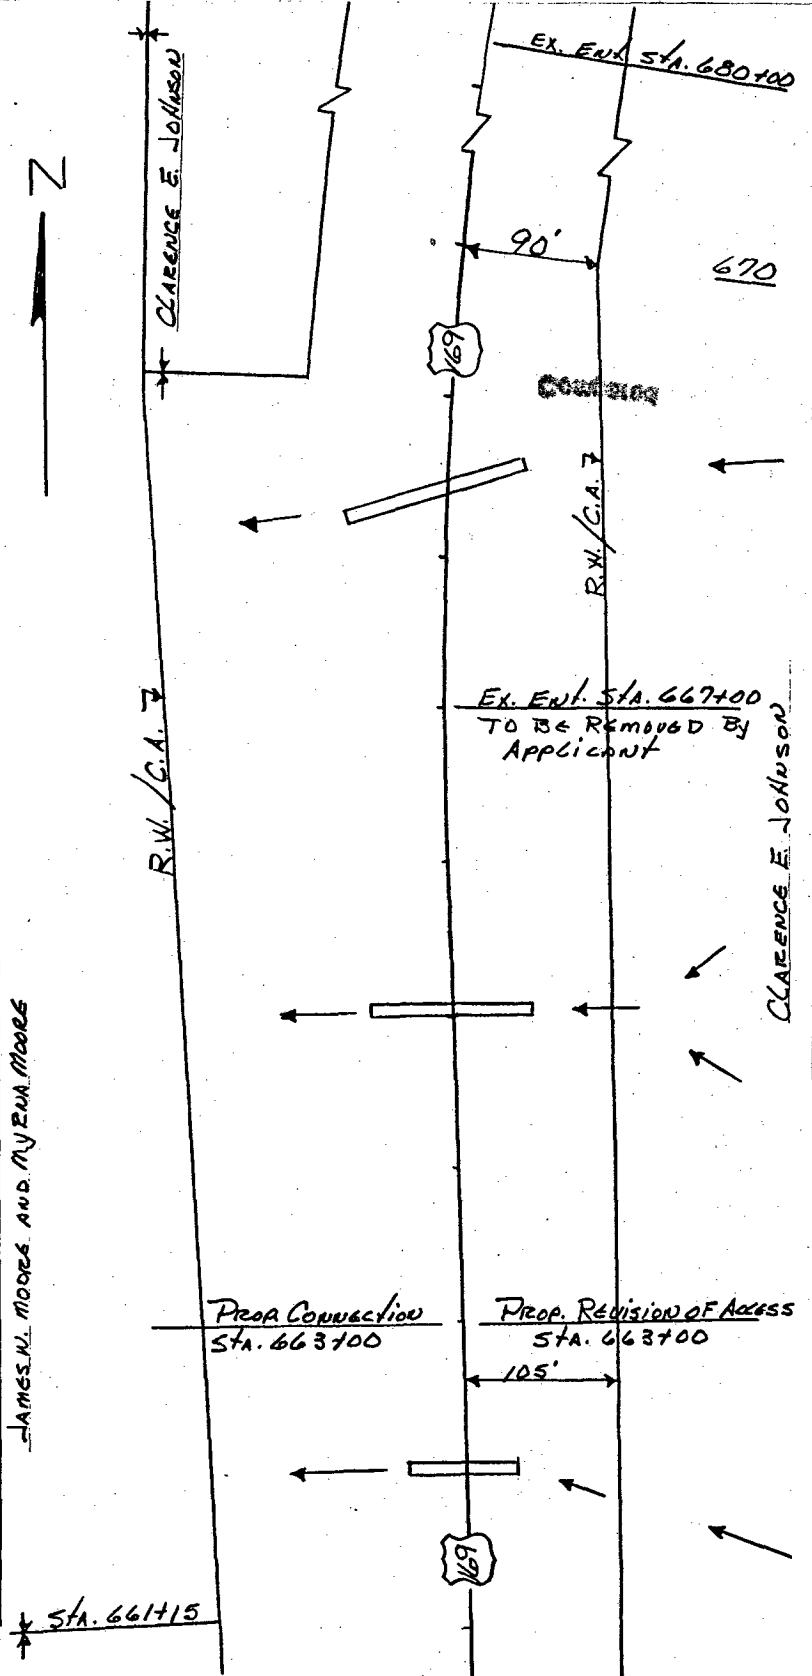

CERTIFICATION

I hereby certify that this sketch was prepared by me or under my direct personal supervision and that I am a duly registered professional engineer under the laws of the State of Iowa.

Date 10/7/82 Signature James J. Danley

Iowa Reg. No. 7324

APPLICANT CLARENCE E. JOHNSON
ADDRESS WINTGESET, IOWA 50873
DATE _____ 19__