
PLAT OF A SURVEY MADE FOR MARY MUNDELL
OF LOT-1 IN BLOCK-6 OF PITZER & KNIGHT'S ADDITION
TO THE CITY OF WINTERSET, MADISON COUNTY, IOWA

FILED NO. 1063
BOOK 2 PAGE 6
PLAT BOOK TOWNS
1985 NOV 20 PM 1:21
MARY E. WELTY
RECORDER
MADISON COUNTY, IOWA
Fee $5.00

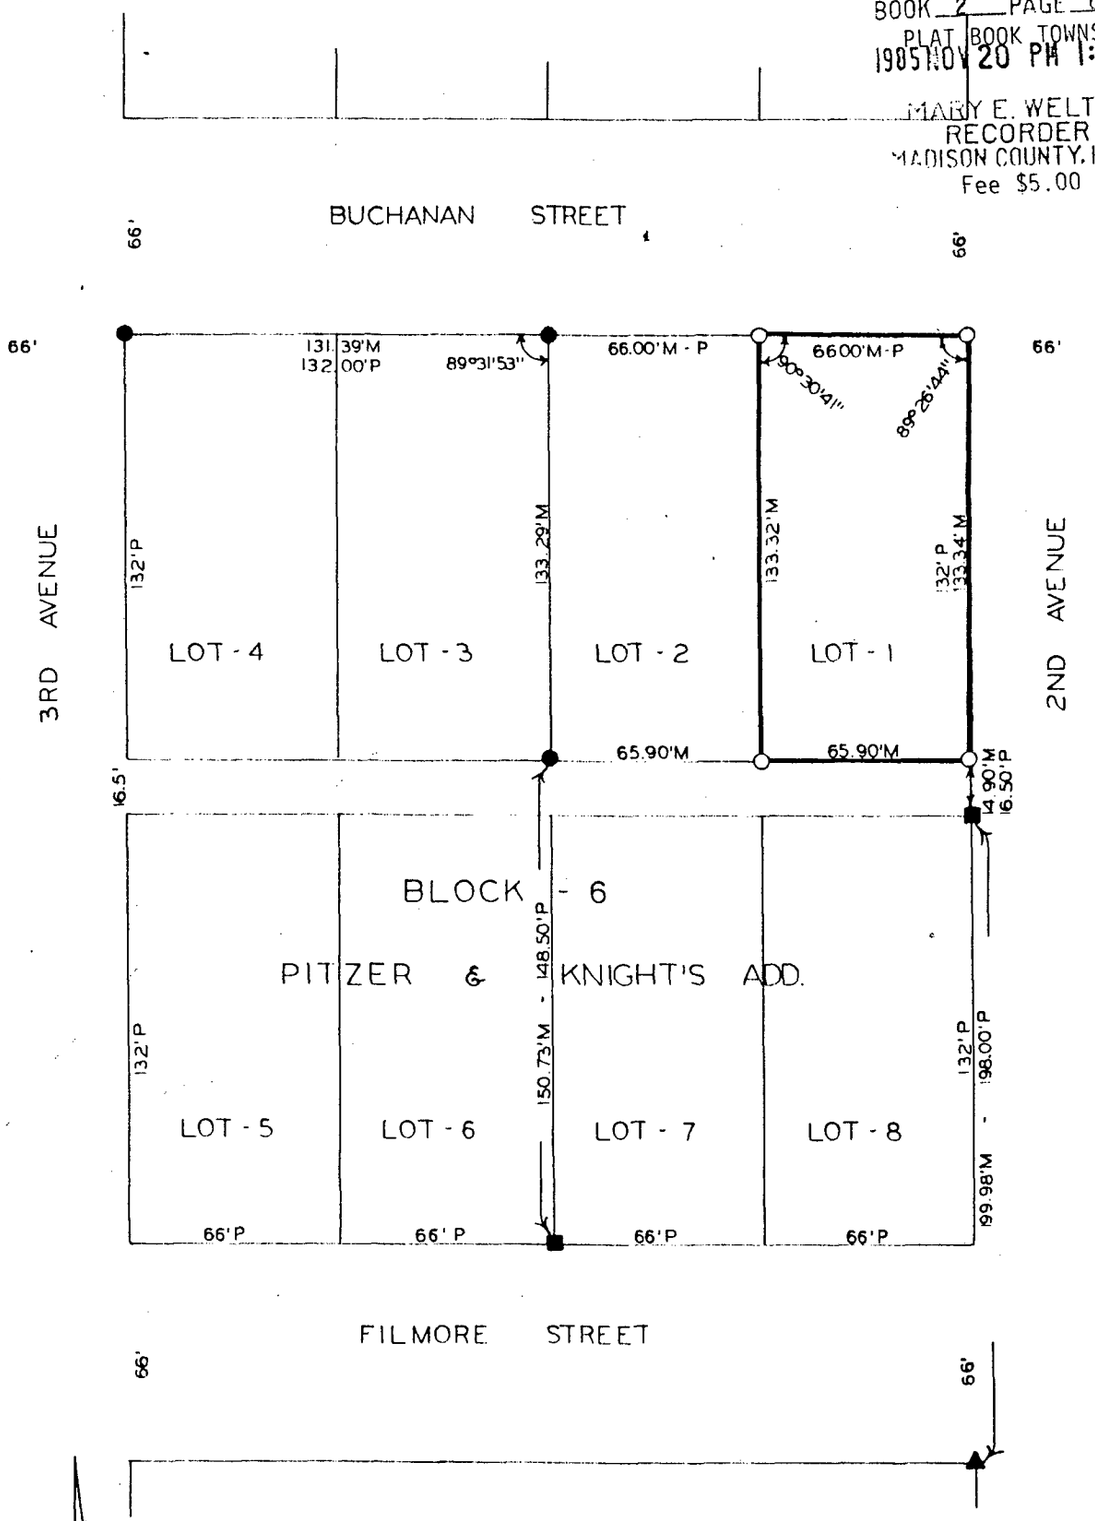

SCALE: 1" = 50'

- ● FOUND IRON PIN
- ■ FOUND IRON PIPE
- ▲ FOUND BRIDGE SPIKE
- O SET C.I.R. #5041
- M MEASURED DISTANCE
- P PLATTED DISTANCE

I HEREBY CERTIFY THAT THIS PLAN, SPECIFICATION, PLAT, MAP, SURVEY OR REPORT WAS MADE BY ME OR UNDER MY DIRECT PERSONAL SUPERVISION AND THAT I AM A DULY REGISTERED PROFESSIONAL ENGINEER AND LAND SURVEYOR UNDER THE LAWS OF THE STATE OF IOWA

SIGNED DATE

Charles T. Vance, P.E. & L.S. Iowa Reg. No. 5041

VANCE & HOCHSTETLER, P.C.
CONSULTING ENGINEERS
71 JEFFERSON STREET
WINTERSET, IOWA 50273